



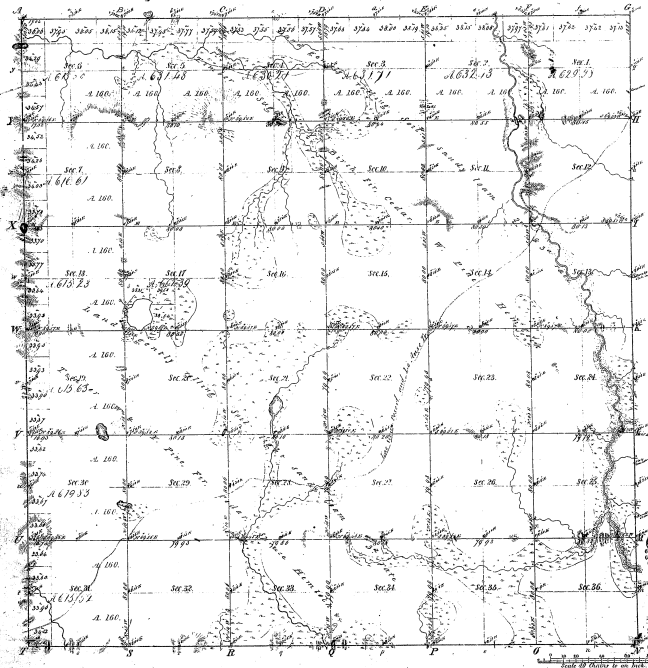

Boundaries of






