Township No. 48 N Range No. 35 W Mer. Mich.

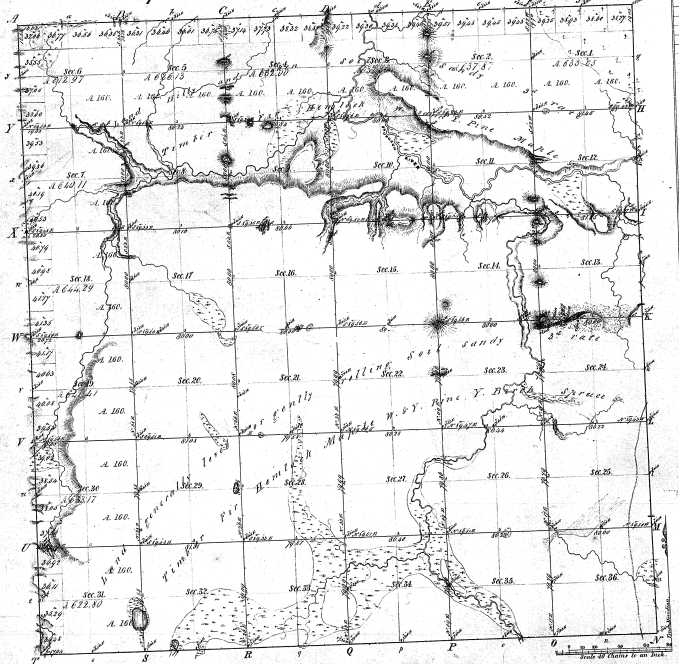

Meanders of								
Poole	Courses	Ch.s Lk.s	Poole	Courses	Ch.s Lk.s	Poole	Courses	Ch.s Lk.s
44-10								

44-10

Total number of Acres: 22 96 376

Surveys Designated	By Whom Surveyed	Date of Contract	Amount of Surveys	When Surveyed	When & for and ch.s in the Surv.r Gen.l's acc.t
Township lines	[illegible]	Sept. 7th 1846	M. Ch.s Lks. 11 - 70 - 60	3rd Quar. 1846	
Subdivisions	F. Coleman	June 3d 1843	60 - 62 - 40	3rd Quar. 1843	

The above Map of Township No. 48 N. of Range No. 35 W. of the Principal Meridian of Michigan is strictly conformable to the field notes of the survey thereof on file in this Office, which have been examined and approved.

Surveyor General's Office.
Detroit Sept. 4th 1854

Leander Chapman
Sur. Gen.l