


Township 1° 50' N. Range 1° 34' W. Mex. Mich.

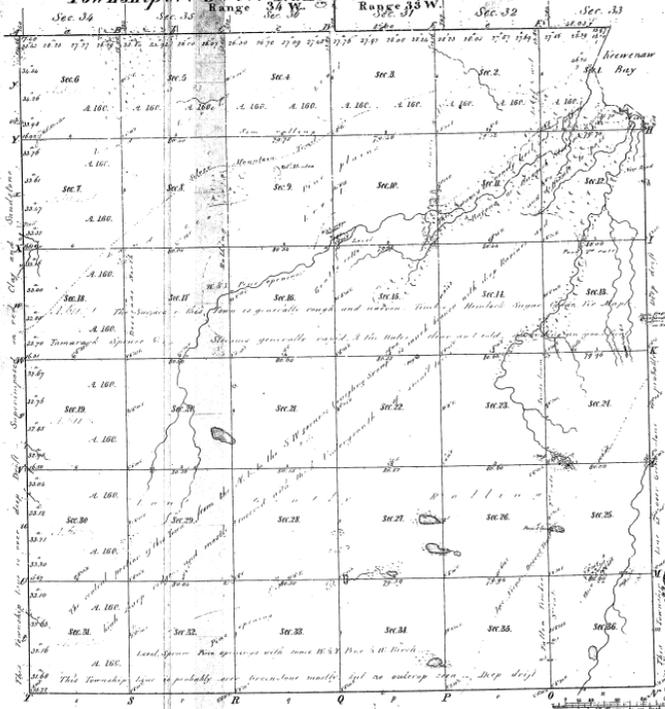

Boundaries of  

44-3

44-3

1. 17. 60

Total number of Acres

Survey Designated	By Whom Surveyed	Date of Contract	Amount of Survey	When Surveyed	Plan of the land and all in the Survey
Township Survey	18° 2 1/2' West	Sept 25 1860	36 1/2 Secs.	1860	
Subdivisions	William D. Smith	1860	36 1/2 Secs.	1860	

The above copy of Township 1° 50' North of Range 1° 34' West of the Principal Meridian Michigan is strictly conformable to the field notes of the survey thereof on file in this office, which have been examined and approved.

Surveyor General's Office  
 Detroit, Mar 10 1860

Charles Wells  
 Surveyor