39-7

Township No. 52 N. Range No. 50 W. Mer. Michigan

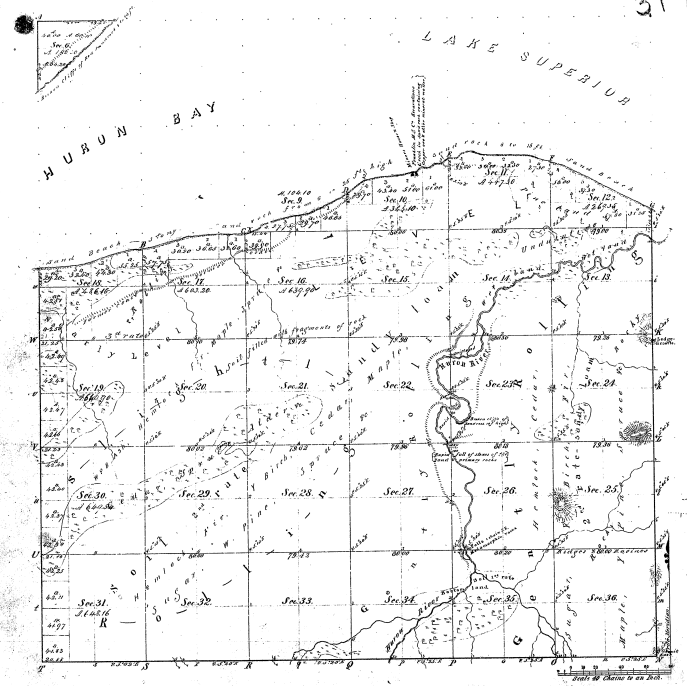

Meanders of								
Posts	Courses	Ch.s Lk.s	Posts	Courses	Ch.s Lk.s	Posts	Courses	Ch.s Lk.s

Total number of Acres 16,527.01

Surveys Designated.	By Whom Surveyed.	Date of Contract.	Amount of Surveys. M.	Ch.s	Lk.s	When Surveyed.	When Changed in the Surv.r Gen.l's Ass.t
Township lines.	Wm. H. Pearl	June 25. 1864	50	00	00	2d qr. 1866	
Subdivisions.	Hubbard & Lee	Sept 7 1866	50	00	00	2d qr. 1866	

The above Map of Township No. 52 North of Range No. 50 West of the Principal Meridian Michigan is strictly conformable to the field notes of the survey thereof on file in this Office, which have been examined and approved.

Surveyor General's Office,
Detroit, Jan. 1st 1867.

Lucius Lyon, Sur.r Genl