39-8

Township No. 52 N. Range No. 31 W. Mer. Michigan.

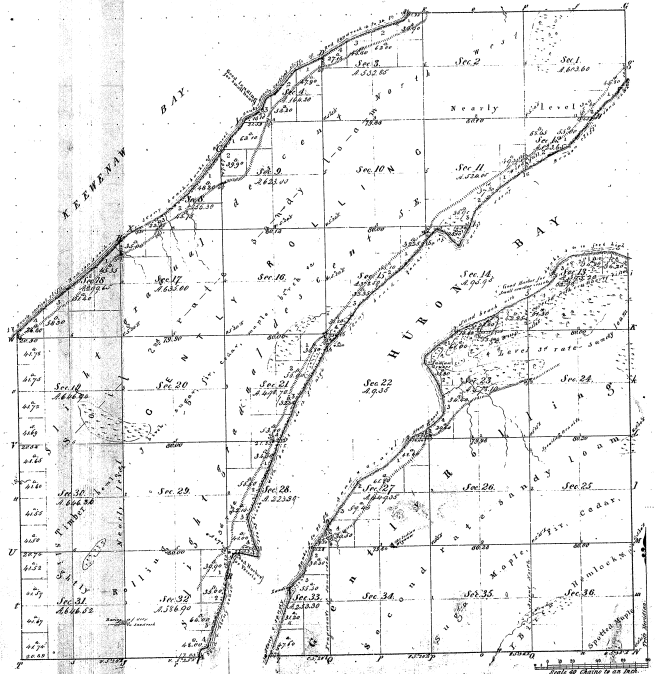

Meanders of								
Posts	Courses	Ch. & Lks	Posts	Courses	Ch. & Lks	Posts	Courses	Ch. & Lks
31-6								

Total number of Acres 15,908.71

Survey Designated	Op. When Surveyed	Date of Contract	Amount of Surveys M. Chs. Lks	When Surveyed	When Charged in the Surv. Genl. Acct.
Township Lines	Fr. A. Bland	June 25 1846	9 51 94	2nd qr. 1846	
Subdivisions	Hubbard & Jones	Sept 7 1846	61 00 52	1st qr. 1846	

The above Map of Township No. 52 North of Range No. 31 West of the Principal Meridian, Michigan is strictly conformable to the field notes of the survey thereof on file in this Office, which have been examined and approved.

Surveyor General's Office
Detroit June 4th 1847

Lucius Lyon Surr. Genl.