6-34

79

Township No. I North, Range No. VII West Mer. (Mer. Ter.)

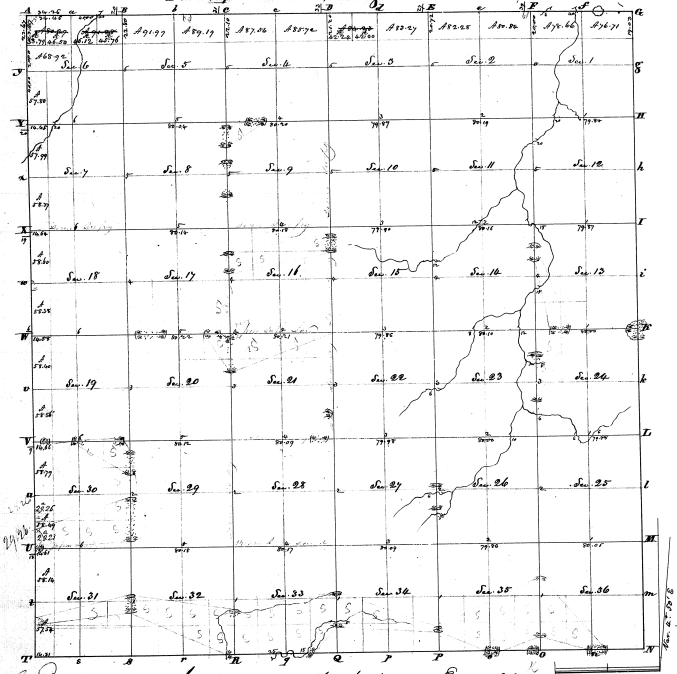

Surveyed in May 1826 – by Musgrove Evans D.S.

Comp.

Contents					
Section	Acres	Hds	Section	Acres	Hds
NL NE 1	76	71	Ele 19	320	
SL " "	80		EL NW "	80	
NL NW "	78	66	WL " "	58	40
SL " "	80		EL SW "	80	
SL " "	320		WL " "	58	56
NL NE 2	80	84	Sec. 20	640	
SL " "	80		21	640	
NL NW "	82	28	22	640	
SL " "	80		23	640	
SL " "	320		24	640	
NL NE 3	83	27	25	640	
SL " "	80		26	640	
NL NW "	84	23	27	640	
SL " "	80		28	640	
SL " "	320		29	640	
NL NE 4	85	72	EL 30	320	
SL " "	80		EL NW "	80	
NL NW "	87	56	WL " "	58	79
SL " "	80		EL SW "	80	
SL " "	320		WL " "	58	49
NL NE 5	89	19	EL 31	320	
SL " "	80		EL NW "	80	
NL NW "	91	99	WL " "	58	14
SL " "	80		EL SW "	80	
SL " "	320		WL " "	57	54
NL NE 6	91	88	Sec. 32	640	
SL " "	80		33	640	
NL NW "	80	29	34	640	
SL " "	68	92	35	640	
SE "	160		36	640	
EL SW "	80			11,389	92
WL " "	57	80		11,432	70
EL 7	320		Total	22,822	62
EL NW "	80				
WL " "	57	99			
EL SW "	80				
WL " "	58	37			
Sec. 8	640				
9	640				
10	640				
11	640				
12	640				
13	640				
14	640				
15	640				
16	640				
17	640				
EL 18	320				
EL NW "	80				
WL " "	58	60			
EL SW "	80				
WL " "	58	38			
	11,432	70			

6-34

Edward Tiffin Surv. Gen.