


Township N. III North, Range N. VIII West Mer. (M^{ts} Ter.)

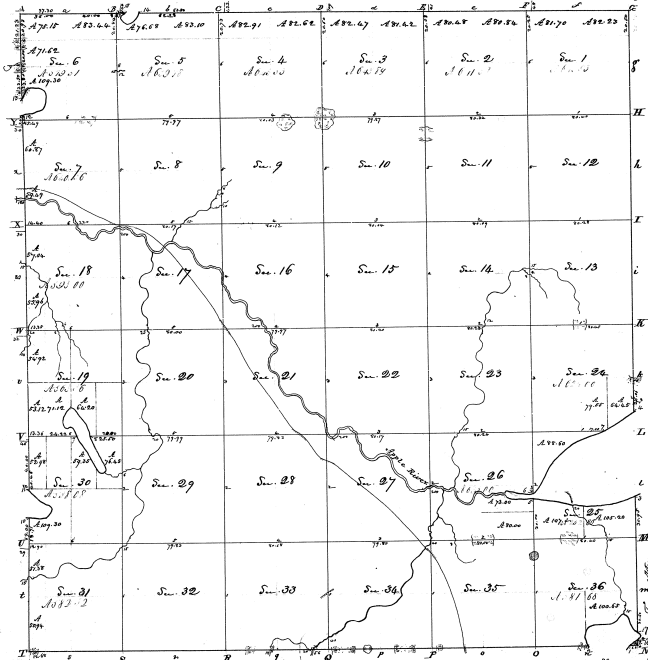

Surveyed in November 1830 - by Sylvester Abbley S^r.

Sections		Acres		Cup Cont.		Acres	
				Total		12379.88	

6-32