


Township N^o 15 N., Range N^o 4 East Mer. (Mich.)

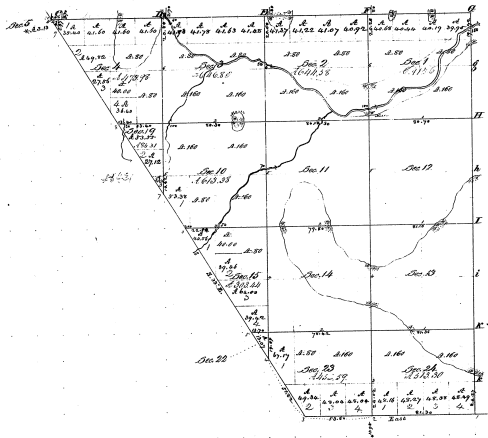

Boundaries of					
From	Course	To	From	Course	To


3
P-3-32

Survey designated	By Whom Surveyed	Date of Sale	Total number of Acres Cont'd	
			When Surveyed	When Sold
Twp. 15 N. 4 E.	V. L. Mott	5, 6, 16, 1839	8, 78-99	2, 79-113, 97
Subdivisions:	Sever	18, 28, 38		

All above lands of Township N^o 15 N. of Range N^o 4 East of the Principal Meridian Michigan is properly conformable to the field notes of the survey above mentioned, which have been examined and approved.

Surveyor General's Office
 Cincinnati May 25 1839

Township N. 11 North, Range N. W East Mer. (M. Ten)

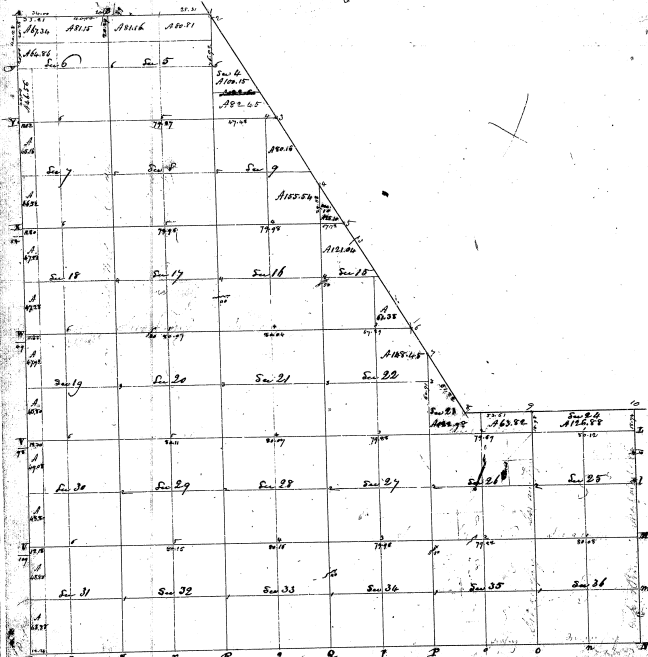


Wm. H. Dyer

23-30