


19 - Survey of
 Township N^o 15N. Range N^o 2E. Mer. Mich.

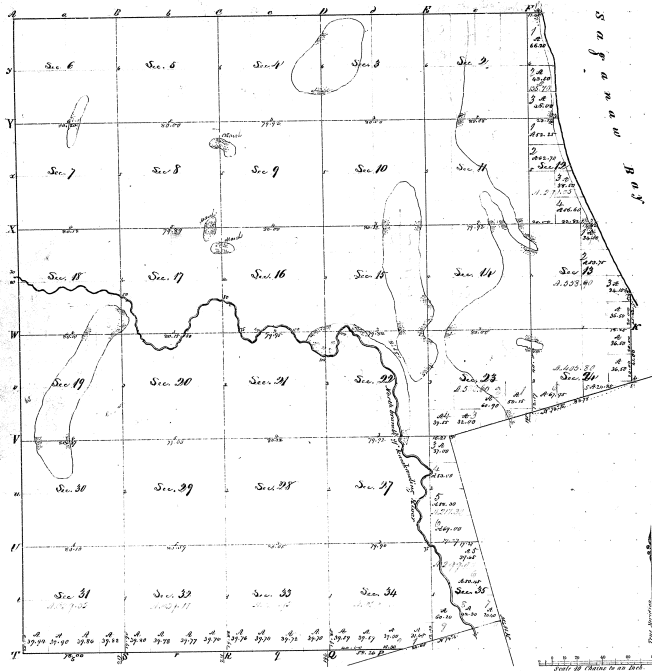

23-2
 Conf.



