Re-survey

Mich. 41

23-16

# Township No. 17 N. Range No. 4 East Mer. (Mich.).

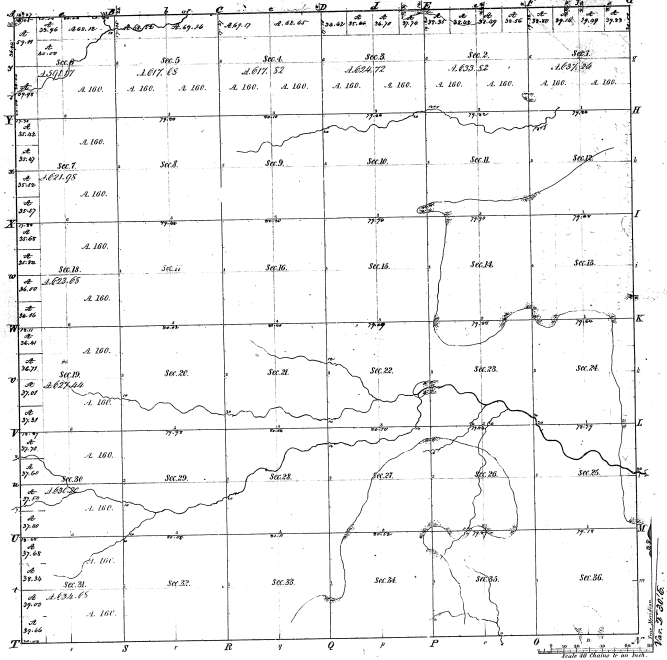


| Meanders of | | | | | | | | | |
|---|---|---|---|---|---|---|---|---|---|
| Posts | Courses | In. Lks. | Posts | Courses | Ch. Lks. | Posts | Courses | Ch. Lks. |
| | | | | | | | | |

Total number of Acres 22,800.45

| Surveys Designated | By Whom Surveyed | Date of Contract | Amount of Surveys | When Surveyed | When pd. or and ch. in the Surv. Gen. Ins. |
|---|---|---|---|---|---|
| S+G Township lines | Joseph Wrapfle | | Ch. Lks. 12. 00. 00 | 1st. yr. 1822 | |
| Subdivisions | John Bart | Aug. 27th 1823 | 59. 61. 90 | 3rd. yr. 1823 | 6th. yr. 1824 |
| Mft. Boundaries | Robert Clark Jr. | Mar. 17th 1830 | 13. 73. 21 | 4th. yr. 1831 | |

The above Map of Township No. 17 North of Range No. 4 East of the Principal Meridian Michigan is strictly conformable to the field notes of the survey thereof on file in this Office, which have been examined and approved.

Surveyor General's Office.
Cincinnati Nov. 2nd 1843

William Johnston
Sur. Gen.