# Township N. V. South, Range N. XVIII West Mer. (Mic. Ter.)

1-18

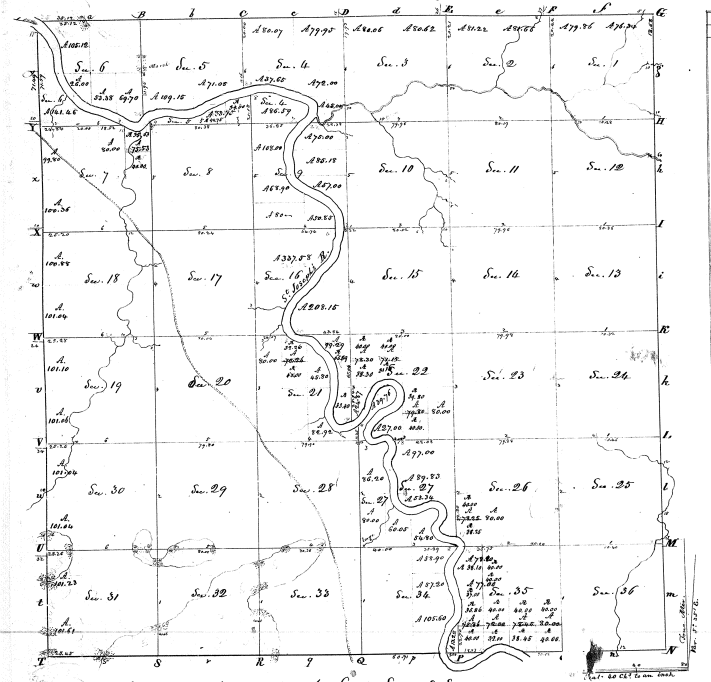


Surveyed in August 1829 - by Lucius Lyon D.S.
& in February 1830 - by John Mullett D.S.

| Contents | | |
|---|---|---|
| Sections | Acres | Hds |
| SW frac. 4 | 86 | 59 |
| S frac. 5 | 83 | 75 |
| SW frac. 6 | 141 | 46 |
| E½ NE 7 | 75 | 53 |
| W½ " " | 80 | |
| E½ NW " | 80 | |
| W½ " " | 99 | 80 |
| SE " | 160 | |
| E½ SW " | 80 | |
| W½ " " | 100 | 36 |
| Sec. 8 | 640 | |
| Wfr. NW 9 | 108 | 00 |
| SWfr. SE " | 50 | 85 |
| N½ SW " | 68 | 90 |
| S½ " " | 80 | |
| W frac. 16 | 337 | 58 |
| Sec. 17 | 640 | |
| E½ 18 | 320 | |
| E½ NW " | 80 | |
| W½ " " | 100 | 88 |
| E½ SW " | 80 | |
| W½ " " | 101 | 04 |
| E½ 19 | 320 | |
| E½ NW " | 80 | |
| W½ " " | 101 | 10 |
| E½ SW " | 80 | |
| W½ " " | 101 | 06 |
| Sec. 20 | 640 | |
| Wfr. NE 21 | 45 | 80 |
| E½ NW " | 72 | 26 |
| W½ " " | 80 | |
| SWfr. SE " | 82 | 92 |
| SW " | 160 | |
| SW frac. 22 | 39 | 76 |
| Wfr. NW 27 | 86 | 20 |
| SWfr. SE " | 54 | 80 |
| E½ SW " | 60 | 05 |
| W½ " " | 80 | |
| Sec. 29 | 640 | |
| 29 | 640 | |
| E½ 30 | 320 | |
| E½ NW " | 80 | |
| W½ " " | 101 | 04 |
| E½ SW " | 80 | |
| W½ " " | 101 | 04 |
| E½ 31 | 320 | |
| E½ NW " | 80 | |
| W½ " " | 101 | 23 |
| E½ SW " | 80 | |
| W½ " " | 101 | 61 |
| Sec. 32 | 640 | |
| 33 | 640 | |
| N½ NE 34 | 58 | 90 |
| S½ " " | 57 | 20 |
| Wfr. SE " | 105 | 60 |
| W½ " " | 320 | |
| | 16,115 | 31 |
| | 12,267 | 60 |
| Total | 22,412 | 91 |

| Contents | | |
|---|---|---|
| Sections | Acres | Hds |
| N½ NE 1 | 76 | 34 |
| S½ " " | 80 | |
| N½ NW " | 79 | 86 |
| S½ " " | 80 | |
| S½ " | 320 | |
| N½ NE 2 | 81 | 66 |
| S½ " " | 80 | |
| N½ NW " | 81 | 22 |
| S½ " " | 80 | |
| S½ " | 320 | |
| N½ NE 3 | 80 | 62 |
| S½ " " | 80 | |
| N½ NW " | 80 | 06 |
| S½ " " | 80 | |
| S½ " | 320 | |
| N½ NE 4 | 79 | 95 |
| S½ " " | 80 | |
| N½ NW " | 80 | 07 |
| S½ " " | 80 | |
| N½ SE " | 72 | 00 |
| S½ " " | 45 | 00 |
| Nfr. SW " | 37 | 65 |
| N½ 5 | 320 | |
| Nfr. SE " | 71 | 05 |
| Nfr. SW " | 109 | 15 |
| NE 6 | 160 | |
| Efr. NW " | 105 | 12 |
| E½ SE " | 69 | 70 |
| W½ " " | 53 | 38 |
| NEfr. SW " | 26 | 00 |
| N½ NE 9 | 75 | 00 |
| S½ " " | 85 | 18 |
| Efr. SE " | 57 | 00 |
| Sec. 10 | 640 | |
| 11 | 640 | |
| 12 | 640 | |
| 13 | 640 | |
| 14 | 640 | |
| 15 | 640 | |
| E frac. 16 | 208 | 15 |
| NE frac. 21 | 99 | 21 |
| NE 22 | 160 | |
| E½ NW " | 71 | 15 |
| W½ " " | 78 | 30 |
| E½ SE " | 80 | 00 |
| W½ " " | 79 | 80 |
| SEfr. SW " | 27 | 00 |
| NWfr. " | 24 | 87 |
| Sec. 23 | 640 | |
| 24 | 640 | |
| 25 | 640 | |
| N½ 26 | 320 | |
| SE " | 160 | |
| E½ SW " | 80 | |
| W½ " " | 78 | 25 |
| N½ NE 27 | 97 | 00 |
| S½ " " | 89 | 83 |
| NEfr. SE " | 53 | 34 |
| SE frac. 34 | 13 | 28 |
| N½ NW 35 | 78 | 10 |
| S½ " " | 77 | 00 |
| E½ SE " | 80 | |
| W½ " " | 78 | 45 |
| E½ SW " | 72 | 00 |
| W½ " " | 75 | 86 |
| NE [illegible] | 160 | |
| Sec. [illegible] | 640 | |

**Township No. 5 S. Range No. 18 W. Mer. Mich.**

*Islands in St. Josephs River.*

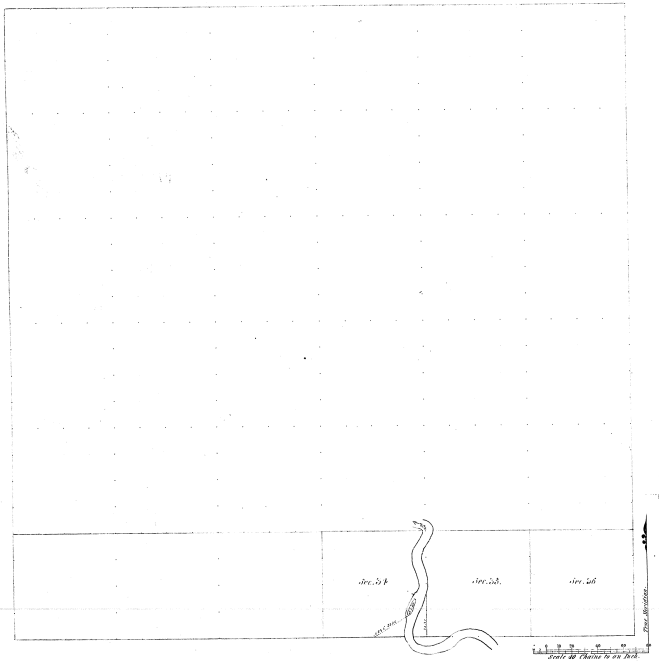


| Meanders of | | | | | | | | |
|---|---|---|---|---|---|---|---|---|
| Posts | Courses | Ch.s Lk.s | Posts | Courses | Ch.s Lk.s | Posts | Courses | Ch.s Lk.s |
| | | | 1 | 18 | | | | |

Total number of Acres 1.40

| Surveys Designated. | By Whom Surveyed. | Date of Contract. | Amount of Surveys M. Ch.s Lk.s | When Surveyed. | When Changed in the Surv.r Genl.s acc.t |
|---|---|---|---|---|---|
| Township lines. Meander Subdivisions. | Jenk Wiskfisch | Oct 18 1846 | 0. 56 50 | Aug. 1845 | |

Stands in the N. Josephs River in

The above Map of Township No. 5 South of Range No. 18 of the Principal Meridian Michigan is strictly conformable to the field notes of the survey thereof on file in this Office, which have been examined and approved.

Surveyor General's Office.
Detroit March 17th 1846

Lucius Lyon, Sur.r Genl.

1-18