


Township N. 11 South, Range N. V West Mer. (Mc.Ter.)

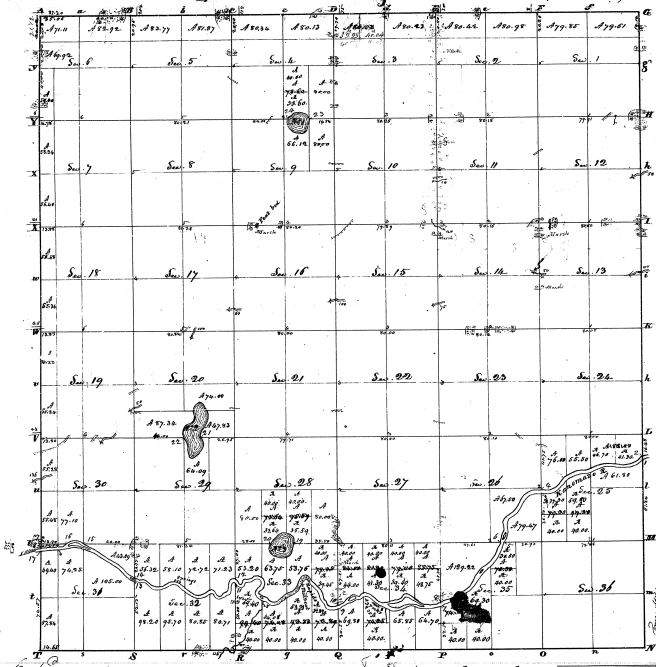

Surveyed in Sept and October 1895 by Lewis Lyon et al.

3-15

