Township No. III south, Range No. V west Mer. (Mic. Tw.)

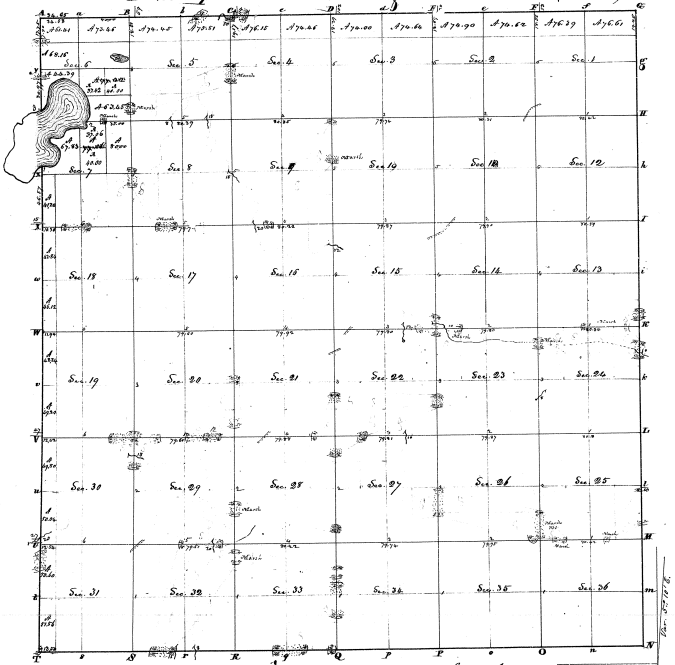

Surveyed in Oct. & November 1825 by Lucius Lyon D.S.

No. of Sec.	Contents Acres	Hund.
N½ NE 1	76	61
S½ "	80	
N½ NW "	76	39
S½ "	80	
" SE "	320	
N½ NE 2	76	62
S½ "	80	
N½ NW "	76	90
S½ "	80	
" SE "	312	
N½ NE 3	76	60
S½ "	80	
N½ NW "	76	
S½ "	80	
" SE "	312	
N½ NE 4	76	66
S½ "	80	
N½ NW "	76	15
S½ "	80	
" SE "	312	
N½ NE 5	78	81
S½ "	80	
N½ NW "	76	55
S½ "	80	
" SE "	312	
N½ NE 6	73	66
S½ "	80	
N½ NW "	61	91
S½ "	65	16
N½ SE "	73	42
S½ "	63	42
" SW "	44	39
E½ NE 7	80	
W½ "	77	06
fr. NW "	67	53
SE "	160	
E½ SW "	80	
W½ "	61	20
Sec. 8	640	
9	640	
10	640	
11	640	
12	640	
13	640	
14	640	
15	640	
16	640	
17	640	
E½ 18	320	
E½ NW "	80	
W½ "	42	82
E½ SW "	80	
W½ "	46	13
	10934	37

No. of Sec.	Contents Acres	Hund.
E½ 19	320	
E½ NW "	80	
W½ "	48	24
E½ SW "	80	
W½ "	49	20
Sec. 20	640	
21	640	
22	640	
23	640	
24	640	
25	640	
26	640	
27	640	
28	640	
29	640	
E½ 30	328	
E½ NW "	80	
W½ "	49	80
E½ SW "	80	
W½ "	80	04
E½ 31	320	
E½ NW "	80	
W½ "	50	60
E½ SW "	80	
W½ "	51	56
Sec. 32	640	
33	640	
34	640	
35	640	
36	640	
	11539	46
	10934	37
	22473	83

3-26

3-26