Township No. IV South, Range No. V West Mer. (Mic. Ter.)

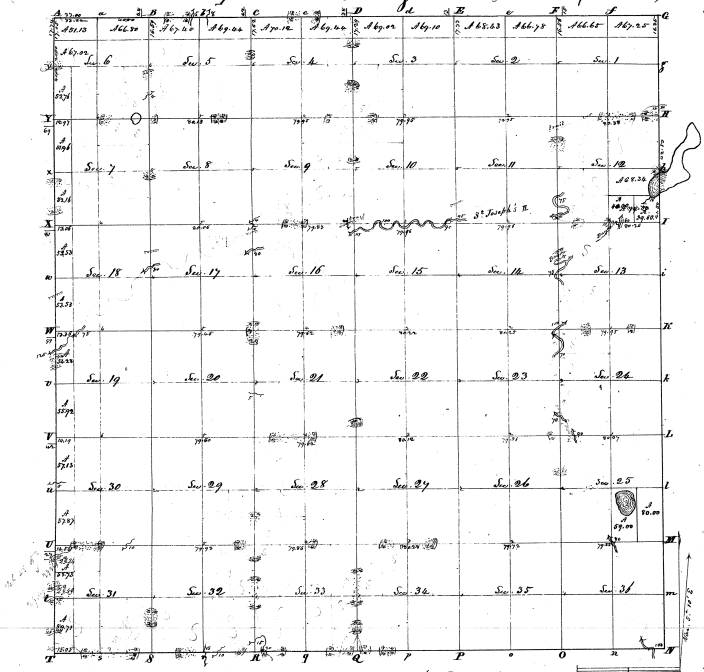

Surveyed in December 1825 – by Robert Clark Jr. D.S.

Section		Contents Acres	Hds.	Section		Contents Acres	Hds.
N½	N E 1	67	25		E½ 19	320	
S½	"	80		E½	NW "	80	
N½	NW "	66	65	W½	"	54	28
S½	"	80		E½	SW "	80	
	S½ "	320		W½	"	59	92
N½	N E 2	66	78		Sec. 20	640	
S½	"	80			21	640	
N½	NW "	68	43		22	640	
S½	"	80			23	640	
	S½ "	320			24	640	
N½	N E 3	69	10		N½ 25	320	
S½	"	80		E½	S E "	80	
N½	NW "	69	02	W½	"	59	
S½	"	80			SW "	160	
	S½ "	320			Sec. 26	640	
N½	N E 4	69	44		27	640	
S½	"	80			28	640	
N½	NW "	70	12		29	640	
S½	"	80			E½ 30	320	
	S½ "	320		E½	NW "	80	
N½	N E 5	69	44	W½	"	57	13
S½	"	80		E½	SW "	80	
N½	SW "	67	40	W½	"	57	87
S½	"	80			E½ 31	320	
	S½ "	320		E½	NW "	80	
N½	N E 6	66	80	W½	"	58	73
S½	"	80		E½	SW "	80	
N½	NW "	57	13	W½	"	59	71
S½	"	67	02		Sec. 32	640	
	S E "	160			33	640	
E½	SW "	80			34	640	
W½	"	52	76		35	640	
	E½ 7	320			36	640	
E½	NW "	80				11,362	64
W½	"	51	96			11,199	36
E½	SW "	80		Total		22,562	00
W½	"	52	16				
	Sec. 8	640					
	9	640					
	10	640					
	11	640					
	N½ 12	320					
N½	S E "	68	34				
S½	"	79	50				
	SW "	160					
	Sec. 13	640					
	14	640					
	15	640					
	16	640					
	17	640					
	E½ 18	320					
E½	NW "	80					
W½	"	52	53				
E½	SW "	80					
W½	"	53	53				
		11,199	36				

3-35