X

Township No. V south, Range No. XIV West Mer. (Mic. Ter.)

2-18

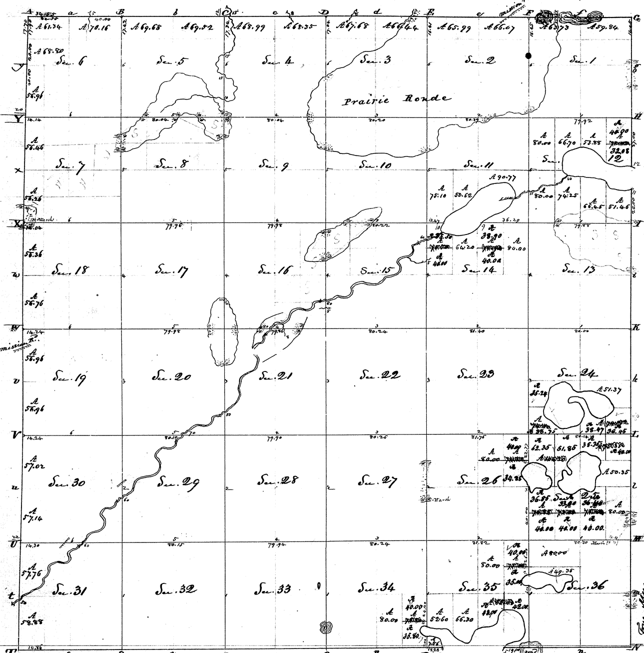

Comp.

Surveyed in Dec. 1829 & Jan. 1830 - by John Mullett, D.S.

Contents			
Sections		Acres	Hds
N½	NE 1	59	84
S½	" "	80	
N½	NW "	63	73
S½	" "	80	
	S½ "	320	
N½	NE 2	66	07
S½	" "	80	
N½	NW "	65	99
S½	" "	80	
	S½ "	320	
N½	NE 3	66	44
S½	" "	80	
N½	NW "	67	68
S½	" "	80	
	S½ "	320	
N½	NE 4	68	35
S½	" "	80	
N½	NW "	68	99
S½	" "	80	
	S½ "	320	
N½	NE 5	69	52
S½	" "	80	
N½	NW "	69	68
S½	" "	80	
	S½ "	320	
N½	NE 6	70	16
S½	" "	80	
N½	NW "	61	34
S½	" "	68	80
	SE "	160	
E½	SW "	80	
W½	" "	56	96
	E½ 7	320	
E½	NW "	80	
W½	" "	56	46
E½	SW "	80	
W½	" "	56	26
	Sec. 8	640	
	9	640	
	10	640	
	N½ 11	340	
	SE "	90	77
E½	SW "	50	62
W½	" "	75	10
E½	NE 12	72	08
W½	" "	53	88
E½	NW "	66	70
W½	" "	80	
E½	SE "	51	46
W½	" "	66	45
E½	SW "	74	25
W½	" "	80	
	Sec. 13	640	
E½	NE 14	80	
W½	" "	78	90
E½	NW "	64	20
W½	" "	75	50
	S½ "	320	
	Sec. 15	640	
	16	640	
	17	640	
	E½ 18	320	
E½	NW "	80	
W½	" "	56	36
E½	SW "	80	
W½	" "	56	76
		11,029	30

Contents			
Sections		Acres	Hds
	E½ 19	320	
E½	NW "	80	
	Sec. 20	640	
	21	640	
	22	640	
	23	640	
	N½ 24	320	
N½	SE "	51	37
S½	" "	74	92
	SW "	74	00
N½	NE 25	75	35
S½	" "	50	35
	NW "	104	20
E½	SE "	80	
W½	" "	76	40
E½	SW "	73	00
W½	" "	76	85
E½	NE 26	74	25
W½	" "	80	
	NW "	160	
	S½ "	320	
	Sec. 27	640	
	28	640	
	29	640	
	E½ 30	320	
E½	NW "	80	
W½	" "	57	02
E½	SW "	80	
W½	" "	57	14
	E½ 31	320	
E½	NW "	80	
W½	" "	57	76
E½	SW "	80	
W½	" "	58	88
	Sec. 32	640	
	33	640	
	N½ 34	320	
E½	SE "	75	80
W½	" "	80	
	SW "	160	
E½	NE 35	75	00
W½	" "	80	
	NW "	160	
	SE	85	00
E½	SW "	66	30
W½	" "	52	60
S.W.	frac. "	7	56
	NE 36	160	
N½	NW "	80	
S½	" "	49	35
	S½ "	320	
		11,006	22
		11,029	30
Total		22,035.52	