


Township N. VI south. Range N. XIV west. (Mic. Ter.)

2-27

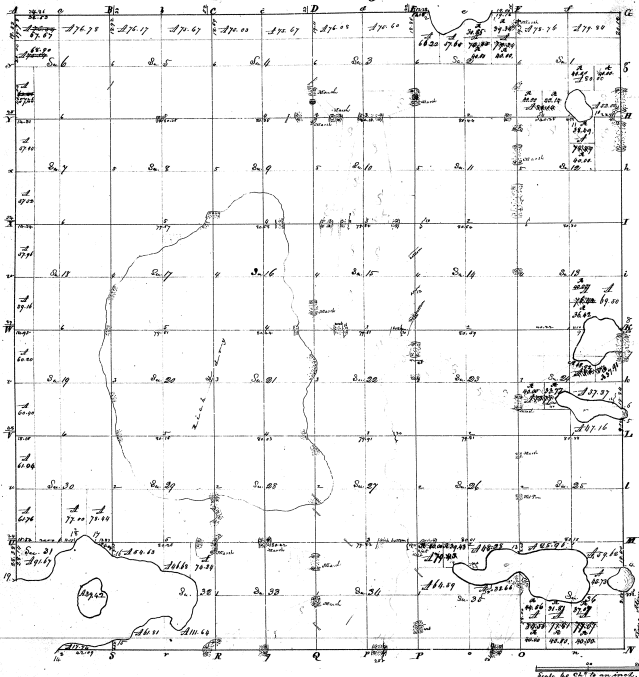

Completed

Surveyed in July 1888 by Calvin Bodman & Son


2-8

ORIGINAL

27-27

TOWNSHIP 6 SOUTH, RANGE 14 WEST, OF THE MICHIGAN MERIDIAN, MICHIGAN.  
PLAT OF AN ISLAND









UNITED STATES DEPARTMENT OF THE INTERIOR  
BUREAU OF LAND MANAGEMENT  





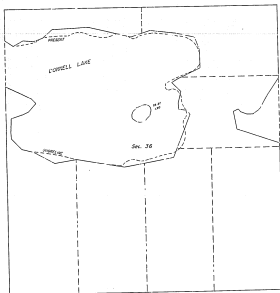

This plat certifies the  
actual measure of Tract 27.