


Township N. VII south, Range N. XVI West (Vic. Ter.)

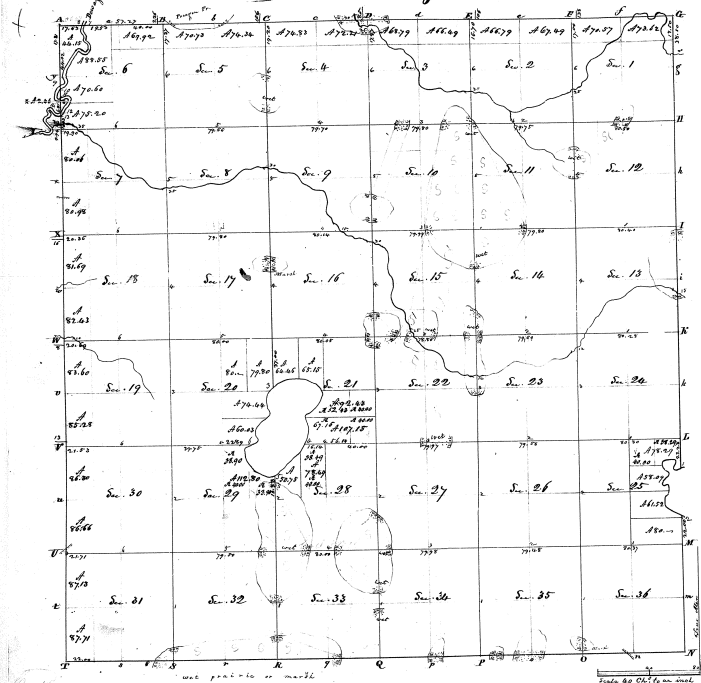

Surveyed in June 1828 - by William Bondfield S.P.

1-31

1-31