


Township 1° 32' N. Range 1° 5' W. Mer. Mich.

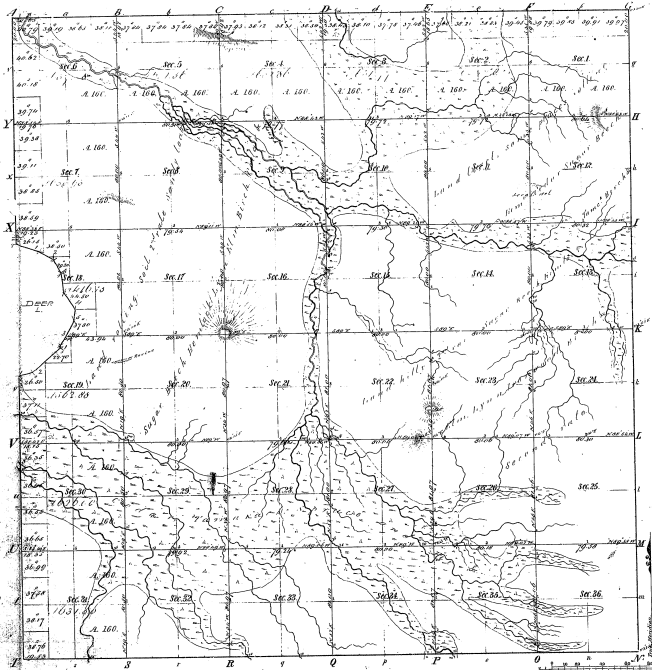

Boundaries of







Total number of Acres 22670.36


The above Map of Township 1° 32' North of Range 1° 5' West of the Principal Meridian Michigan is a stretch conformable to the field notes of the survey thereof filed in the office which have been examined and approved
 Surveyor General's Office
 Detroit Jan 22 1860
 Charles Noble Surveyor

18
25

18-25