Township. No 33 N. Range No 4 W. Mer. Mich.

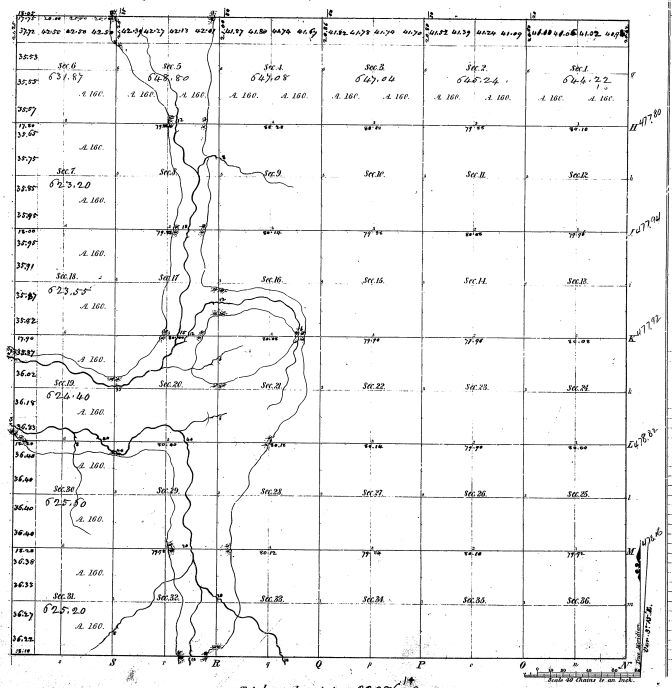

Meanders of

Poste	Courses	Chs. Lks.	Poste	Courses	Chs. Lks.	Poste	Courses	Chs. Lks.

Total number of Acres 22986.86

Surveys Designated	By Whom Surveyed	Date of Contract	Amount of Surveys	When Surveyed	When the Surveys were sent to the Surr. Gen.l's Office
Township lines	[illegible]	June 15th 1820	Oct. 23 27	22 " 1820	Sept. 30 1820
Meanderings	[illegible]	[illegible]	314.14	31 " 1821	Aug. 4 1824

The above Plats of Township No. 33 N. of Range No. 4 W. of the Principal Meridian, Michigan is strictly conformable to the field notes of the surveys returned into this Office, which have been examined and approved.

Surveyor Generals Office, Cincinnati June 24th 1824.

Surr. Genl.

17

18-17