


Township 1° 33' N Range 1° 7' W Mer.

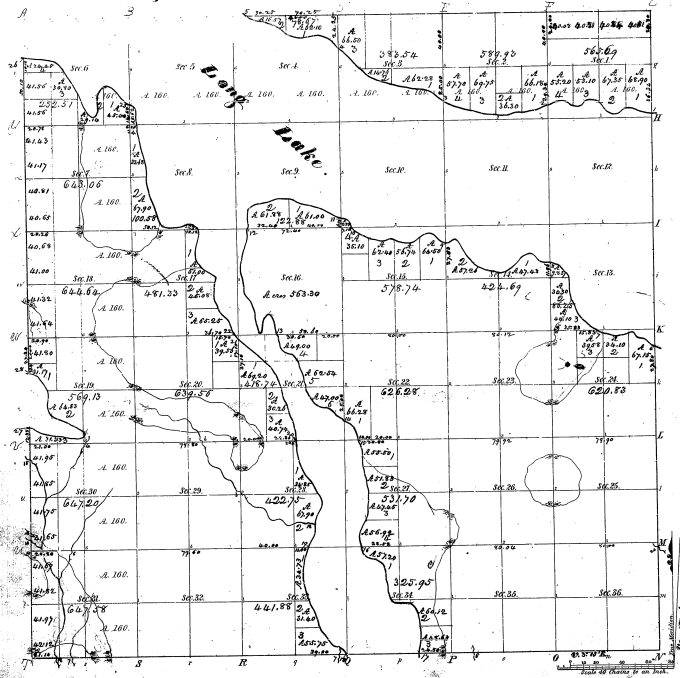

Total number of Acres 15,886.50




PLAT
OF AN ISLAND
IN
PINE LAKE,
Sec. 28, T. 33 N. R. 7 W. MICH. MERDN.
MICHIGAN.

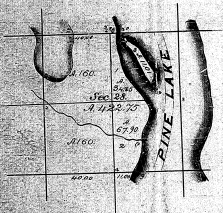

The above Diagram of Island No 3 in Section 28, T. 33 N. R. 7 W. Michigan Meridian, in the State of Michigan, is a correct Plat of Survey executed by Lewis K. Robinson, U.S. Deputy Surveyor, in pursuance of Instructions from the Commissioner of the General Land Office, bearing date the 23rd day of January, 1882, and is strictly conformable to the field notes thereon, which have been examined and approved.

Paid per Report 37307

18-14 (2)

Scale 40 Chains to an Inch.

Department of the Interior
General Land Office,
April 12th, 1882.

A. C. McFarland
Commissioner
& Ex. Officer Surveyor General
Michigan