


Township 12th 33rd N. Range 1st 1st E. Mer. Mich.

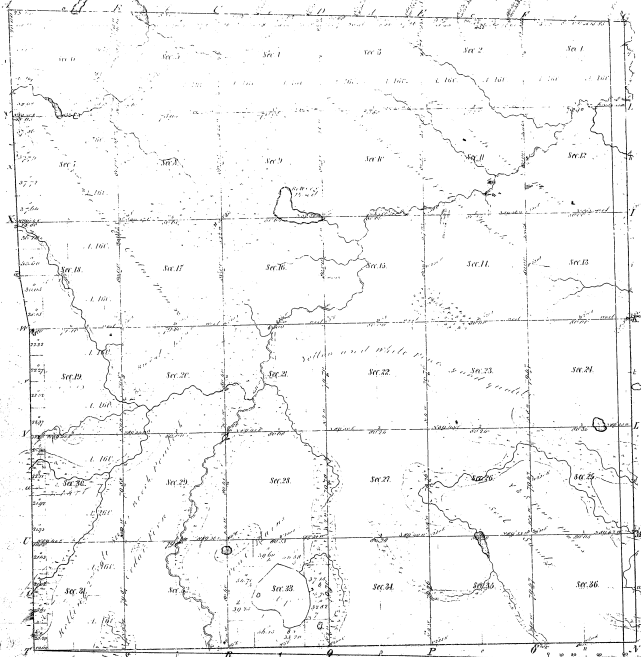

Measured by
 Prof. ... 18th ... 17th ... 18th ...

21-10

Total number of Acres 27162.0

Survey Designated	By Whom Surveyed	Date of Commencement	Amount of Acres	When Surveyed	How Surveyed	How Taken and A.C.
2 nd Survey Township line	Sheldon B. ...	April 15 th 1857	6 22 22	1857
Subdivision	William B. ...	April 20 th 1857	64 12 23	1857

The above Map of Township 12th 33rd N. 1st 1st E. of Range 1st 1st East of the Principal Meridian Michigan is a correct representation of the field notes of the survey thereof on file in this office, which have been examined and approved.
 Surveyor General's Office
 Detroit, Jan. 20 1857
 Charles A. Allen Surveyor Genl.