18-19

Township No. 33 N. Range No. 2 W. Mer. Mich.

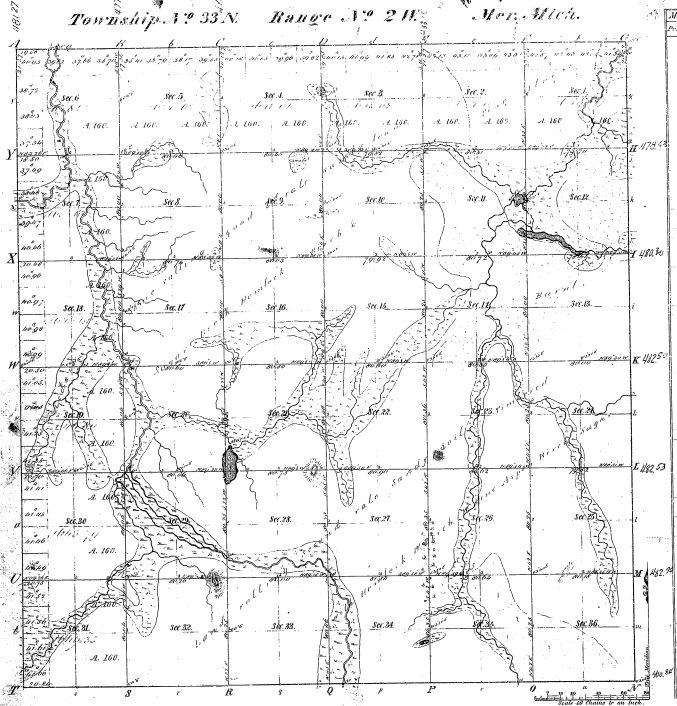

Meanders of							
Posts	Courses	Ch. Lk.	Posts	Courses	Ch. Lk.	Posts	Courses	Ch. Lk.

Total number of Acres 2206.80

Surveys Designated	By Whom Surveyed	Date of Contract	Amount of Surveys	When Surveyed	When Sup.d or and ch.d in the Sur. Gen.l Ofc.
Township Lines	John Mullett	Jan 15. 1840	Mi. 42 Ch. 51 Lk. 50	2nd Quar. 1840	
Subdivisions	Wm. Burt	April 20 1854	Mi. 60 " 93	2nd Quar. 1850	

The above Map of Township No. 33 North of Range No. 2 West of the Principal Meridian Michigan is strictly conformable to the field notes of the survey thereof on file in this Office, which have been examined and approved.

Surveyor Generals Office.
Detroit Nov. 22. 1850.

Chester Bolles Sur. Genl.

16