Township No. 34 N. Range No. 1 W. Mer. Mich.

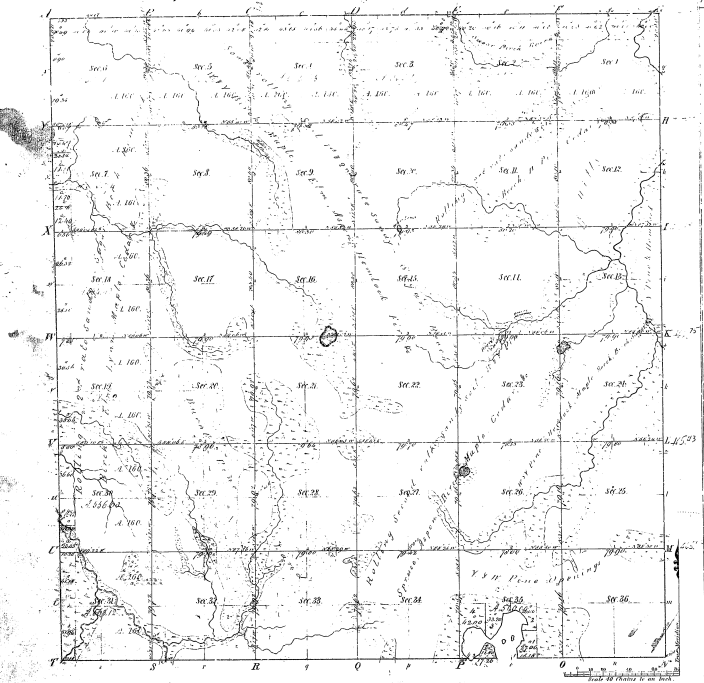

Meanders of

Poals Courses	18th Lk.	Poals Courses	18th Lk.	Poals Courses	18th Lk.

Total Meanders
2 miles 03 Chains 06 Lks

Total number of Acres 22,3[illegible]4.90

Surveys Designated	By Whom Surveyed	Date of Contract	Amount of Surveys	Whom Surveyed	When Sd. Acc. with Ins. Gen. Co. ins.
Elect. Bdy. Sr. Tenth Ins. 1840	John Mackenzie John Mackenzie	Jan. 1st 1840 Jan. 1st 1840	M. Ch. Lks. M. M. M.	2nd Quar. 1840 2nd Quar. 1840	
Subdivisions	Jackson Hart	Apr. 19. 1850	61 16 31	2nd Quar. 1850	

The above Map of Township No. 34 North of Range No. 1 West of the Principal Meridian Michigan is strictly conformable to the field notes of the surveys thereof, on file in this Office, which have been examined and approved.

Surveyor General's Office
Detroit Dec. 23 1850

Charles A. Clark Spr. Genl.

18-4