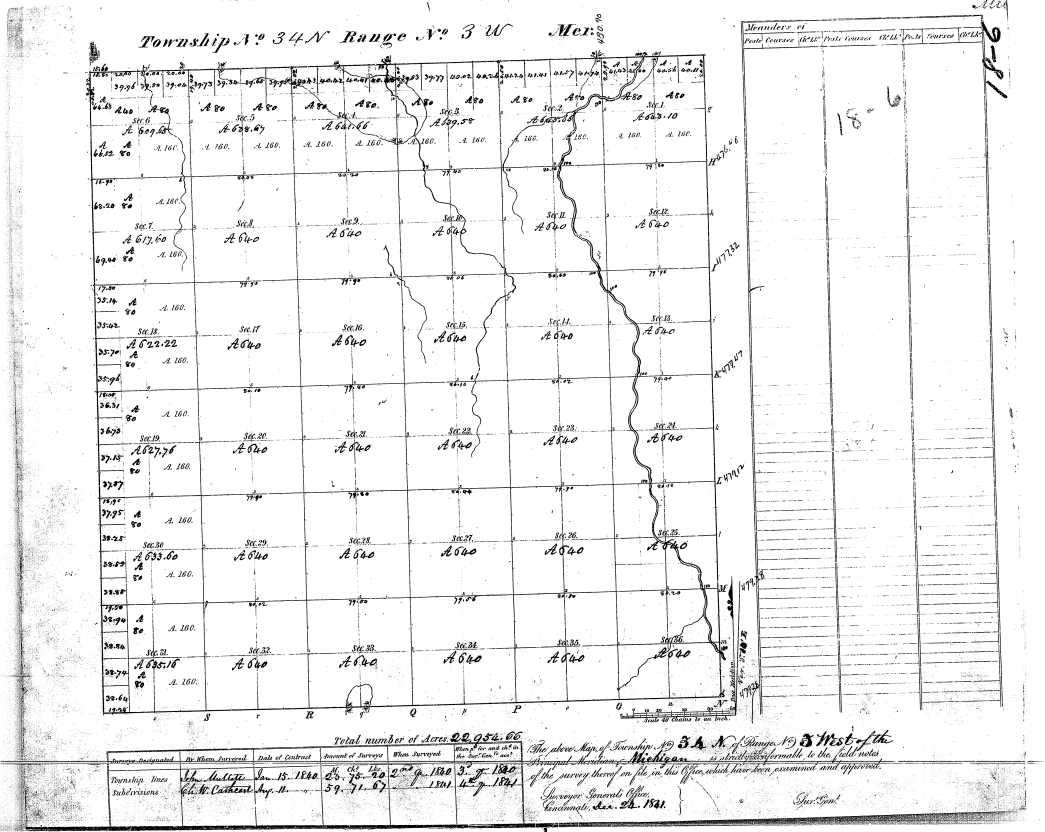

Total number of Acres 22,954.66

Surveys Designated	By Whom Surveyed	Date of Contract	Amount of Surveys	When Surveyed	When Approved for and at the Surveyor Gen.l's office
Township lines	Lt. Austin	Jan. 15. 1840	25. 72. 20	2nd Q. 1840	3rd Q. 1840
Subdivisions	Lt. W. Caldwell	Aug. 11.	59. 71. 67	1841	4th Q. 1841

The above Map of Township No. 34 N. of Range No. 3 West of the Principal Meridian, Michigan, is accepted, conformable to the field notes of the survey thereof on file in this Office, which have been examined and approved.

Surveyor Generals Office
Cincinnati, Dec. 22. 1841.

Sur. Genl