


Reserved
Township 17° 35' N. Range 17° 2' W. Gen. Mich.

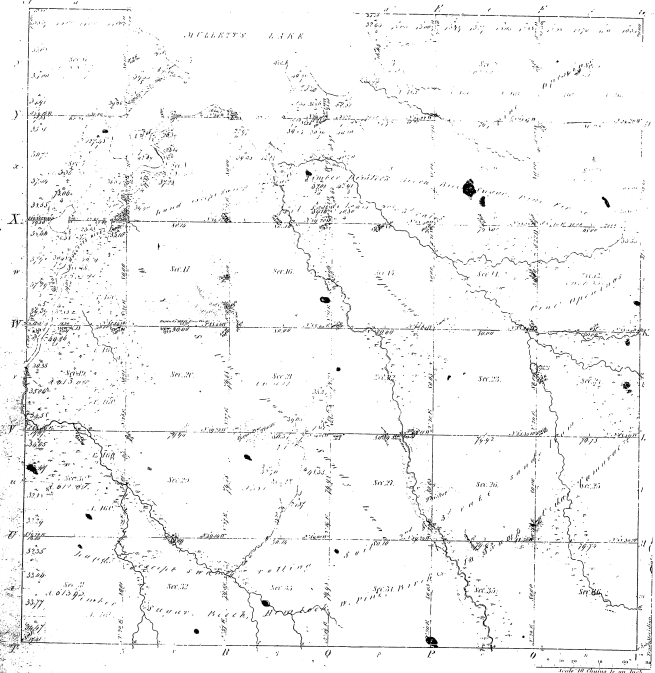

10-2
18-24


Number of feet 47' 10"

Total number of Acres 2,330.50

Survey	Discovered & by Whom	Date of Contract	Amount of Survey	When Surveyed	When Paid for and by Whom
Township	John Mullin	Jan 15 th 1848	75 77 1/2	2 nd Nov. 1848	
Individuals	Harro Mullin	April 8 th 1848	70 18 98	3 rd Nov. 1848	

The above map of Township 17° 35' North of Range 17° 2' West of the Principal Meridian of Michigan is truly and correctly as surveyed and approved by the surveyors and by the State which have been mentioned and approved.

Surveyor General's Office
Lansing, Michigan 22nd 1858

Sealed & Certified
Geo. S. Smith

Comd Copy made
Deft Copy made