


Recovery  
Township N<sup>o</sup> 36 N Range N<sup>o</sup> 1 W. ——— Mer. Mich.

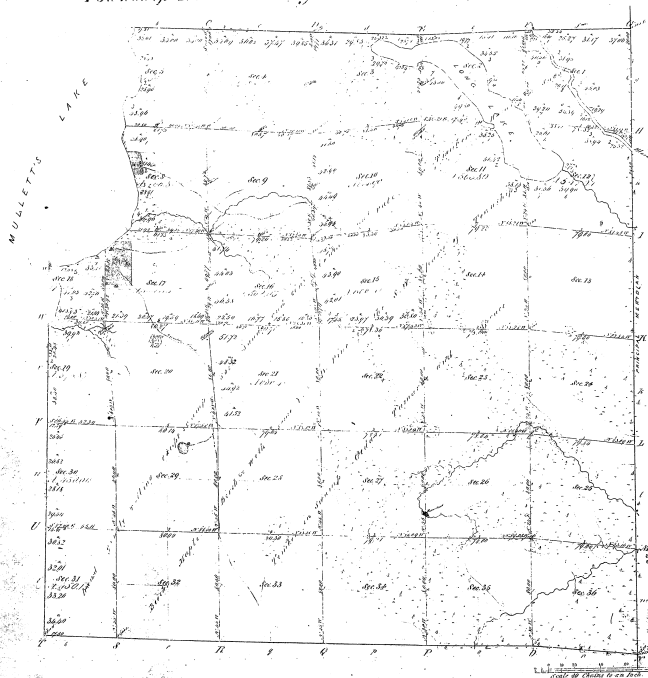

14-19

81-61



Total number of acres 2860.36

Survey	By Whom Surveyed	Date of Contact	Number of Acres	When Surveyed	How Surveyed

The above Rep. of Township N<sup>o</sup> 36 North of Range N<sup>o</sup> 1 West of the Principal Meridian of Michigan is fully conforms to the field notes  
and approved by me  
George S. Carleton, Cor. Comm.

Saml. Chapman, Ass. Cor.  
Detroit July 22<sup>nd</sup> 1864