Resurvey

Township No. 38 N. Range No. 2 W. Mer. Mich.

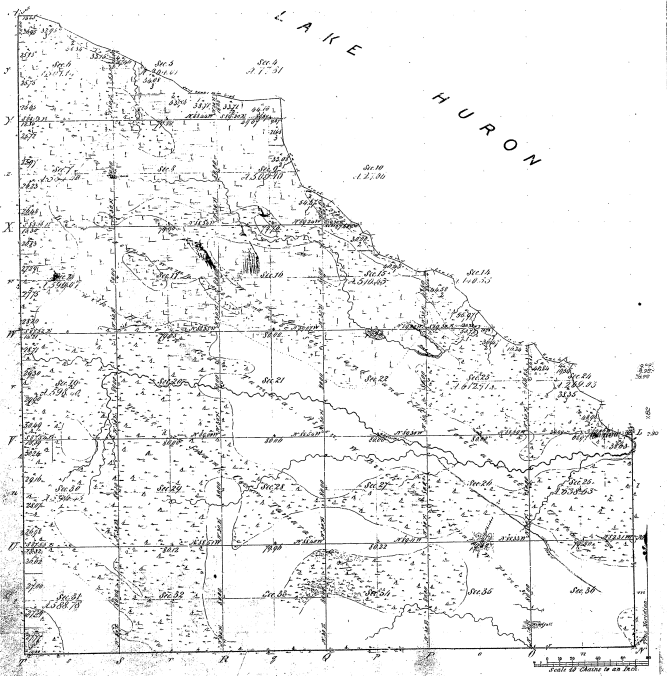

Meanders of Parts	Courses	Ch^s Lk^s	Parts	Courses	Ch^s Lk^s	Parts	Courses	Ch^s Lk^s

19-7

Meander 7 miles 66 chs. 75 lks

Total number of Acres 16657

Survey Designated.	By Whom Surveyed.	Date of Contract.	Amount of Survey M.	Ch^s	Lk^s	When Surveyed.	When Charged to the Surv^r Genl Acc^t
Township Lines.	[illegible]	[illegible]	[illegible]	[illegible]	[illegible]	3^d Quart. 1846	
Subdivisions.	Harvey Mellen	April 6th 1846	51	35	99	2nd Quart. 1846	

The above Map of Township No. 38 North of Range No. 2 West of the Principal Meridian of Michigan is strictly conformable to the field notes of the survey thereof on file in this office, which have been examined and approved.

Surveyor General's Office,
Detroit Decr 8th 1856.

Geo. W. Chapman Sur. Genl

Comp^d 28 mar