19-5

Township No. 39. N. Range No. 2. W. Mer. Mich.

Meanders of Lake Huron								
Posts	Courses	Ch.s Lks.	Posts	Courses	Ch.s Lks.	Posts	Courses	Ch.s Lks.
2	S 53 E	11.00						
1	S 32 E	7.75						

1 ft + 5

LAKE HURON.

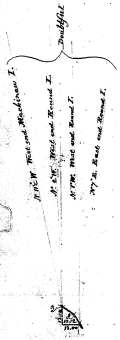

Total number of Acres

Survey Designated.	By Whom Surveyed.	Date of Contract.	Amount of Surveys M. Chs. Lks.	When Surveyed.	When Charged in the Surr. Genl's acct.
Township lines.	John Mullett	Jan. 15. 1840	26. 14	3d qr. 1840	3d qr. 1840
Subdivisions.	J. H. Mullett	Aug. 11. 1840	18. 75	4th qr. "	1st qr. 1841

The above Map of Township No. 39 N. of Range No. 2 West of the Principal Meridian Michigan is strictly conformable to the field notes of the survey thereof on file in this Office, which have been examined and approved.

Surveyor General's Office.
Cincinnati, Feb. 24. 1841.

C. B. Fleming Asst. Genl.