48-39

# Township No. 41 N. Range No. 4 W. Mer. Mich.

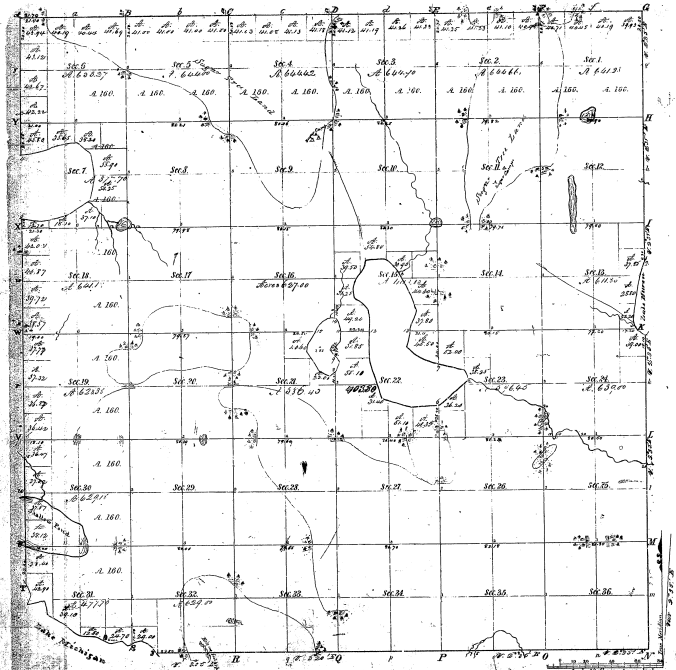


| Meanders of | | | | | | | | |
|---|---|---|---|---|---|---|---|---|
| Posts | Courses | Chs. Lks. | Posts | Courses | Chs. Lks. | Posts | Courses | Chs. Lks. |
| | | | | | | | | |

48-39

Total number of Acres 22,667.77

| Surveys Designated | By Whom Surveyed | Date of Contract | Amount of Surveys | When Surveyed | When pd. to and Ack. in the Dist. Con. Ge. Ofc. |
|---|---|---|---|---|---|
| Township lines | Wm. H. Knight | Jany. 15. 1840 | | 3d. yr. 1840 | |
| Subdivisions | J. H. Mullett | April 2d. 1845 | 68 37 21 | 3d. yr. 1845 | |

The above Map of Township No. 41 North of Range No. 4 West of the Principal Meridian Michigan is hereby conformable to the field notes of the survey thereof on file in this Office which have been examined and approved.

Surveyor General's Office
Detroit Michigan 1845 [illegible]