Township No. 44 N. Range No. 1 W. Mer. Mich.

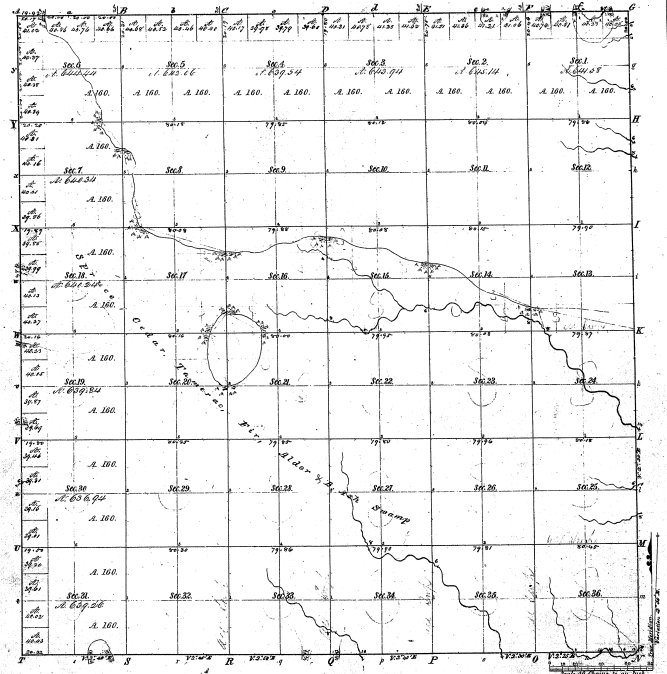

Meanders of								
Posts	Courses	Ch. Lks.	Posts	Courses	Ch. Lks.	Posts	Courses	Ch. Lks.

34-28

Total number of Acres: 23053.32

Surveys Designated	By Whom Surveyed	Date of Contract	Amount of Surveys	When Surveyed	When pd. for and ch. to the Sur. Gen. acct.
Township lines	Wm. A. Burt	Jan. 15. 1840	M. Chs. Lks.	2d qr. 1840	
Subdivisions	J. H. Mitchell	April 2. 1845	60 - 01 - 06	2d qr. 1845	

The above Map of Township No. 44 N. & North of Range No. 1 West of the Principal Meridian Michigan is strictly conformable to the field notes of the survey thereof on file in this Office which have been examined and approved.

Surveyor General's Office
Detroit Sept. 10th 1845

Lucius Lyon, Surv. Genl.