Township No. 44 N. Range No. 2 W. Mer. Mich.

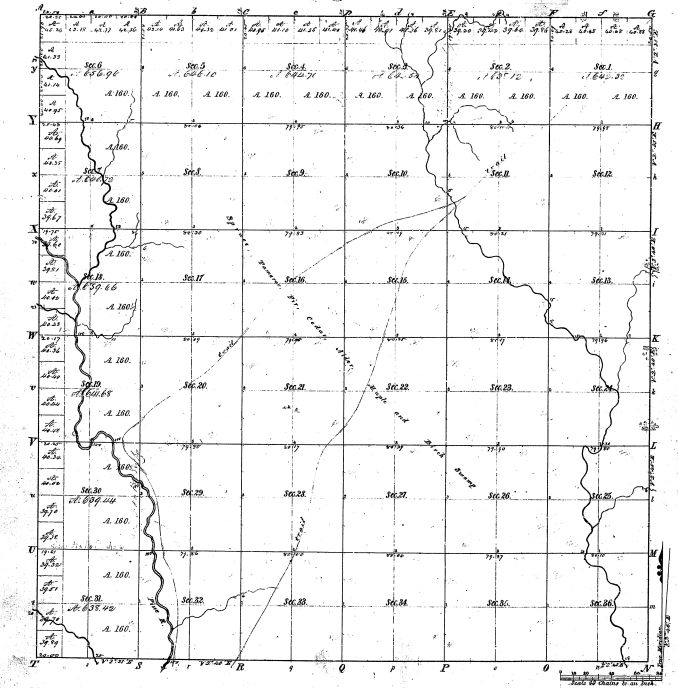

Meanders of

Posts	Courses	Ch. Lk.	Posts	Courses	Ch. Lk.	Posts	Courses	Ch. Lk.

34-21

34-29

Total number of Acres. 23670.66

Surveys Designated	By Whom Surveyed	Date of Contract	Amount of Surveys	When Surveyed	When sent for and ch'd in the Surv. Gen'l Ass'n
Township lines	Wm. A. Burt	Jan. 15th 1840	M. Ch. Lks.	3rd 1840	
Subdivisions	J. H. Mullett	April 2nd 1845	60.02.23	3rd 1845	

The above Map of Township No. 44 North of Range No. 2 West of the Principal Meridian Michigan is strictly conformable to the field notes of the survey thereof on file in this Office, which have been examined and approved.

Surveyor General's Office,
Detroit Sept. 10th 1845 } , Lucius Lyon, Surv. Genl.