


Township N^o 44. N. Range N^o 5 W. Mer. (Mich.)

Original Plat. 1855

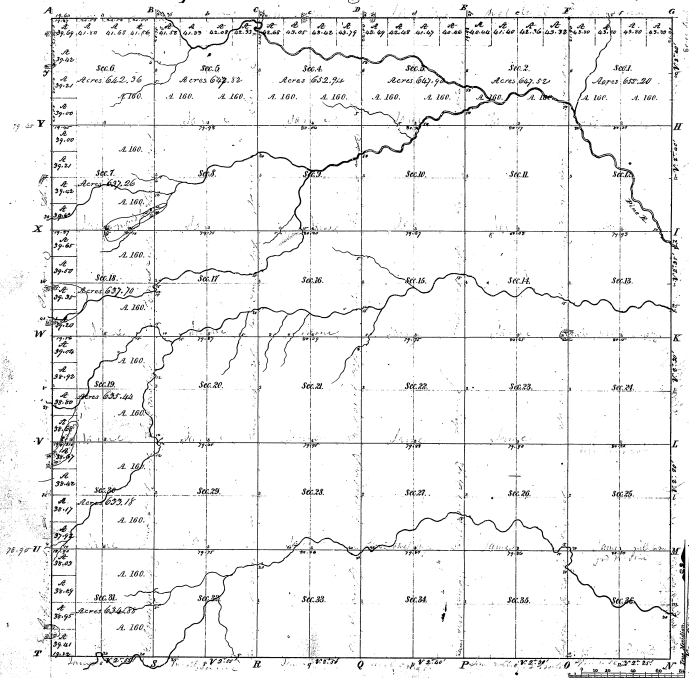

Boundaries of		Public Courses		Private Courses		Public Courses	
Plat	Course	Plat	Course	Plat	Course	Plat	Course
34-30							
34-30							

34-30

Total number of acres 2723.22

Survey designated	By whom surveyed	Date of Contract	Amount of Survey	When Surveyed	How far and in what direction from the lot
Township	J. A. S. S.	July 10 th 1855	62 27 22	1855	
Subdivisions	James A. McMillan	July 10 th 1855	62 27 22	1855	

This plan, map of Township N^o 44 North of Range N^o 5 West of the Principal Meridian Michigan is strictly conformable to the field notes of the survey being on file in the office and has been examined and approved by the Surveyor General's Office
 Witness my hand
 Detroit, July 28th 1855

Lucius L. Jones
 Surveyor General