


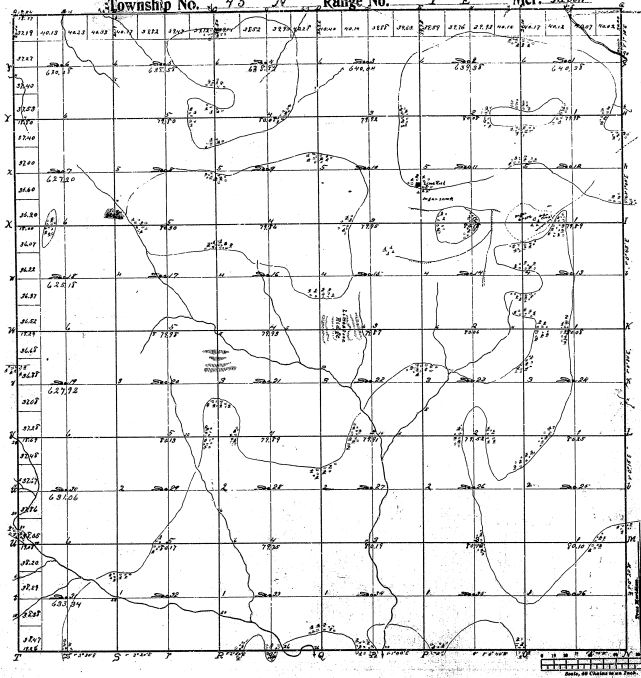

Township No. 45 N Range No. 1 E Mer. 13th

COPY



Mileage of					
From	To	Ch. Lin.	From	To	Ch. Lin.

Total Number of Acres 22,972.00


The above Map of Township No. 45 North of Range No. 1 East of the Principal Meridian 13th is strictly conformable to the field notes of the survey thereof on file in this office, which have been examined and approved.  
 Surveyor General's Office.  
 J. L. A. Davis  
 Surveyor General.