Township № 45 N. Range № 3 W. Mer. Mich.

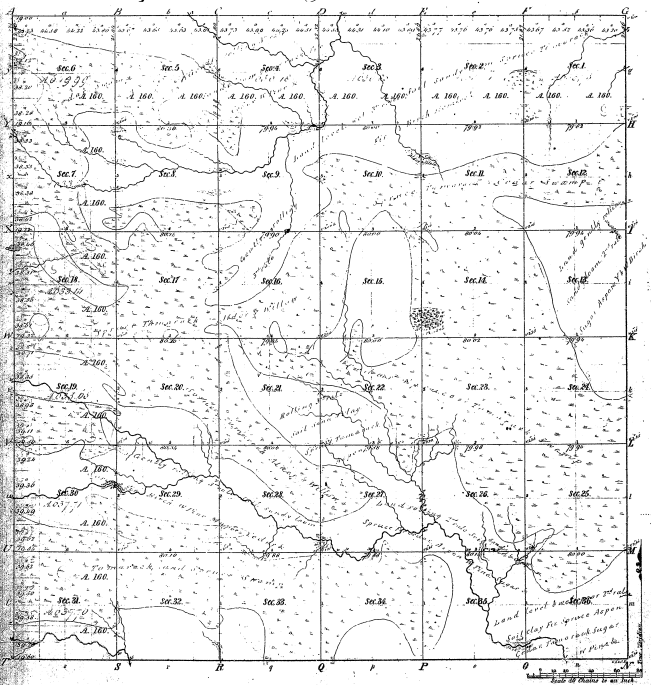

Meanders of

Westerly Courses	Dist.	Easterly Courses	Dist.	Northerly Courses	Dist.

34° 2'

30-25

Total number of Acres 23104.30

Surveys Designated	By Whom Surveyed	Date of Contract	Amount of Surveys	When Surveyed	Whether Sec. and ¼ ¼ on the Sec. Lines are run
Township lines	Wells & Fitch	June 29. 1846	46 03 40	2nd June 1847	
Subdivisions	Harvey Mallory	June 29. 1846	160 87 10	1st June 1849	

The above Map of Township № 45 North of Range № 3 West of the Principal Meridian Michigan is strictly conformable to the field notes of the survey thereof on file in this Office, which have been examined and approved.

Surveyor Generals Office
Detroit Mar 16 1850

Charles Noble
Surv. Genl.