



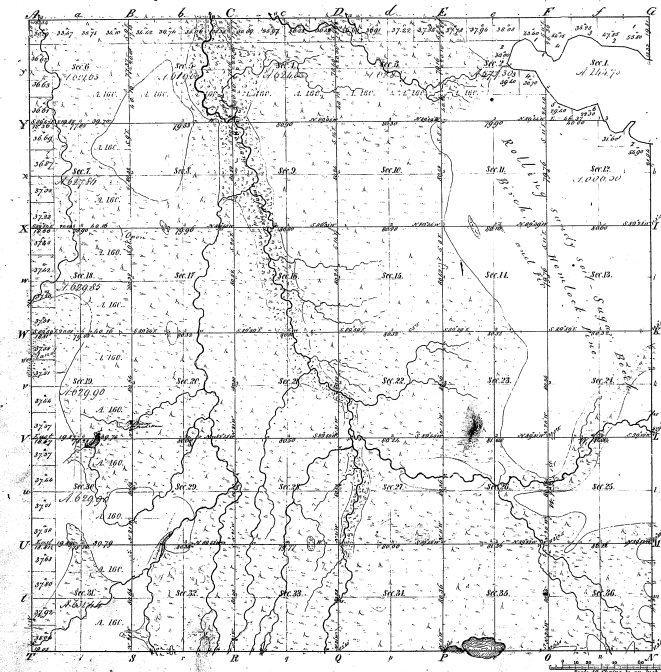

Measures of

24-21

34-21

Number 300 over 716.

Total number of Acres 22,111.31

Survey designated	By Whom Surveyed	Date of Completion	Amount of Survey	When Surveyed	How long in use for the purpose of the survey
Township line	W. A. Burt	June 15, 1824	36	1824	2nd Quarter 1824
Subdivisions	W. A. Burt	June 29, 1824	62,76.28	1824	2nd Quarter 1824

 Survey General's Office
 Detroit June 5, 1827


 Surveyor