Township No. 46 N, Range No. 5 W. Mer. Mich.

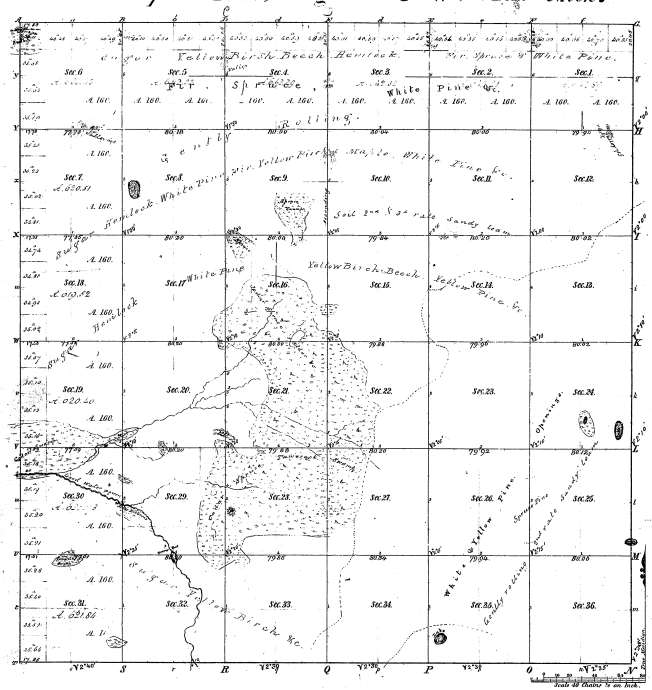

Meanders of								
Posts	Courses	Ch. Lk.	Posts	Courses	Ch. Lk.	Posts	Courses	Ch. Lk.
34-18								

34-18

Total number of Acres: 22,939.28

Surveys Designated	By Whom Surveyed	Date of Contract	Amount of Surveys	When Surveyed	When Sur. Gen. Ins. and ch. in the Sur. Gen. Ins.
Township lines	Wm. A. Hewitt	June 5th 1849	M. Ch. Lk.	5th Mo. 1849	
Subdivisions	Harvey Mellon	June 29. 1849	39 70 49	5th Mo. 1849	

The above Map of Township No. 46 North of Range No. 5 West of the Principal Meridian Michigan is strictly conformable to the field notes of the survey thereof on file in this Office, which have been examined and approved.

Surveyor General's Office,
Detroit Mar. 14. 1850.

Charles Noble
Spr. Genl.

Copy made