Township No. 47 N. Range No. 6 W. Mer. Mich.

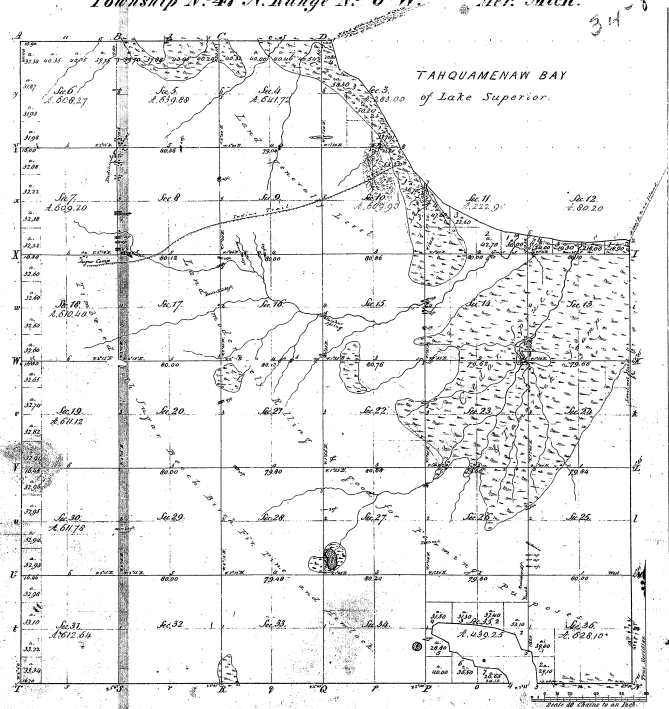

Total number of Acres 20,000.36

Survey Designated.	By Whom Surveyed.	Date of Contract.	Amount of Surveys M. Ch. Lks.	When Surveyed.	When Charged to the Surveyor Gen'l and Receiver.
Township Lines.	William A Burt.	June 15. 1840.	0 66 40	3rd qr 1840.	
Subdivisions.	Wells Burt.	June 29. 1839.	640 26 80	Sept & Oct 1840.	

The above Map of Township No. 47 North of Range No. 6 West of the Principal Meridian, Michigan, is strictly conformable to the field notes of the Surveys thereof on file in this Office, which have been examined and approved.

Surveyor Generals Office, Detroit, May 14th 1842.

Chas. Noble, Asst. Genl.

Boundary of Fract. Courses. Var. Dist. Fract. Courses. Var. Dist. Fract. Courses. Var. Dist.