35-6

Township No. 49 N. Range No. 7 W. Mer. Mich.

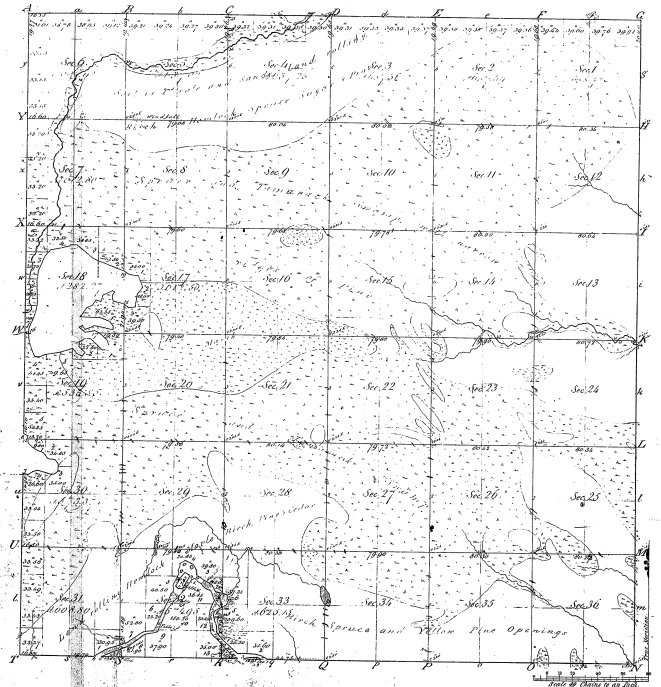

Meanders of								
Posts	Courses	Ch. Lks.	Posts	Courses	Ch. Lks.	Posts	Courses	Ch. Lks.

Total number of Acres 22200.13

Surveys Designated	By Whom Surveyed	Date of Contract	Amount of Surveys M.	Ch.	Lks.	When Surveyed	When Charged in the Surv. Genl. acct.
Township lines	Wm. A. Burt	Jan 15 1849	11	76	67	3rd qr 1849	
Subdivisions	Wm. A. Burt	June 29 1849	270	57	36	3rd qr 1849	

The above Map of Township No. 49 North of Range No. 7 West of the Principal Meridian Michigan is strictly conformable to the field notes of the survey thereof on file in this Office which have been examined and approved.

Surveyor Generals Office
Detroit Mar. 14th 1850

Charles Noble Sur. Genl.

16