Resurvey

Township No. 20 N. Range No. 6 W. Mer. Mich.

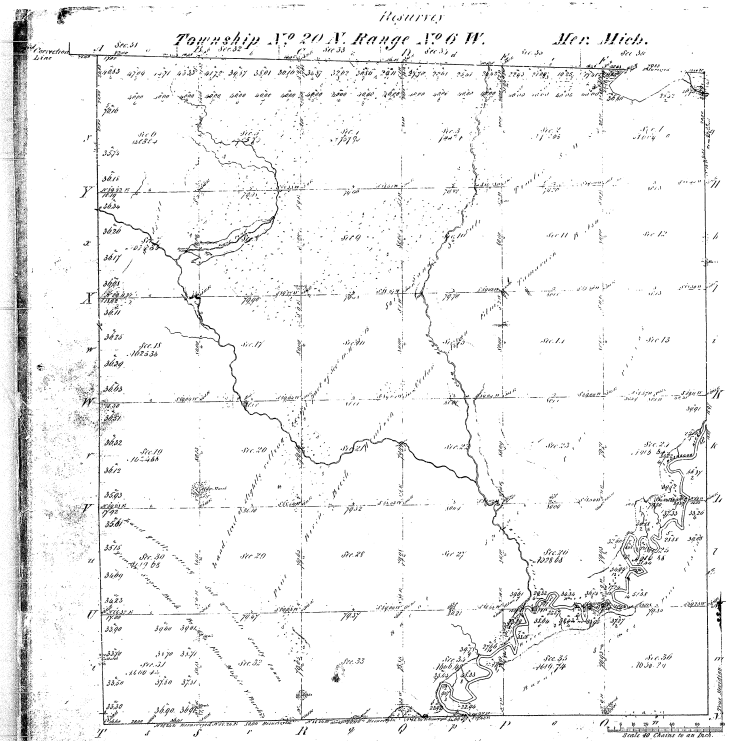

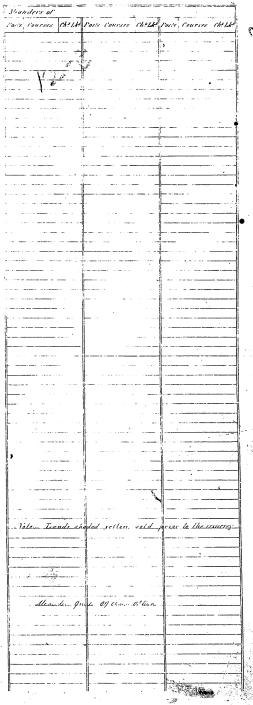

12-3

Surveys Designated.	By Whom Surveyed	Date of Contract	Journal of Surveys Ch.	Journal of Surveys Lks.	When Surveyed	When Changed in the Gen.l Land Office
Township lines	H. Nicholson	July 1831	7	36	60 1st Quar. 1836	
Subdivisions Resurveyed	F. Coleman	April 20th 1836	3	38	61 3d Quarter 1836	
Subdivisions	F. Coleman	April 20th 1836	14	66	01 3d Quar. 1836	
Corrected Boundary	Milton Mc Clure	Instruction May 16th 1837	1	00	50 2d Quar. 1837	

Total number of Acres 23421 94

The above Map of Township 20 North of Range 6 West of the Principal Meridian of Michigan is strictly conformable to the field notes of the survey returned to this office, which have been examined and approved.

Surveyor General's Office
Detroit June 21st 1837

Surveyor General