Township N. VII North, Range N. IV West Mer. (Mi. Ter.)

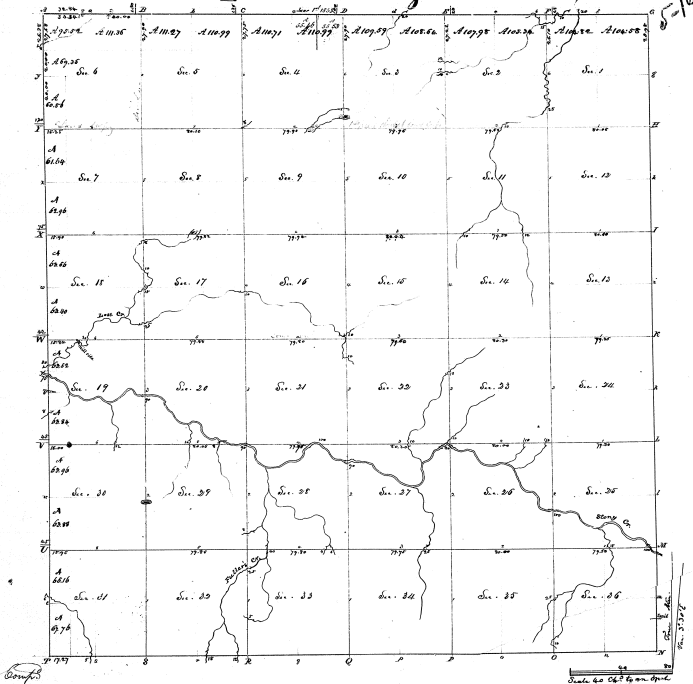

Surveyed in March 1831 by Joel Wright, D. S.

The above Map of Township No. 7 N. Range No. 4 W. of the Meridian (Mich. Ter.) is strictly conformable to the field notes of the Survey thereof on file in this Office, which have been examined & approved.

Surveyor General's Office
Cincinnati, Oct. 6th 1831

M. T. Williams
Surveyor General

5-16

Section		Lot	Acres	Section		Lot	Acres	
N½	NE	1	104	88	Sec.	20	640	
S½			80			21	640	
N½	NW		104	82		22	640	
S½			80			23	640	
	S½		320			24	640	
N½	NE	2	105	36		25	640	
S½			80			26	640	
N½	NW		107	98		27	640	
S½			80			28	640	
	S½		320			29	640	
N½	NE	3	107	62		30	320	
S½			80		E½	NW	80	
N½	NW		107	59	W½		63	96
S½			80		E½	SW	80	
	S½		320		W½		63	88
N½	NE	4	110	99		31	320	
S½			80		E½	NW	80	
N½	NW		110	71	W½		63	16
S½			80		E½	SW	80	
	S½		320		W½		67	76
N½	NE	5	110	99	Sec.	32	640	
S½			80			33	640	
N½	NW		111	27		34	640	
S½			80			35	640	
	S½		320			36	640	
N½	NE	6	111	26			11 880	76
S½			80				12 360	63
N½	NW		79	58	Total		23 181	39
S½			69	36				
	S½		160					
E½	SE		80					
W½			60	32				
	E½	7	320					
E½	NE		80					
W½			61	64				
E½	SW		80					
W½			62	96				
	Sec.	8	640					
		9	640					
		10	640					
		11	640					
		13	640					
		12	640					
		14	640					
		15	640					
		17	640					
	E½	18	320					
E½	NE		80					
W½			63	56				
E½	SW		80					
W½			63	40				
	E½	19	320					
E½	NE		80					
W½			63	52				
E½	SE		80					
W½			63	84				
			12 300	63				