


Re-Survey
Township 1° 25' N. Range 1° 3' W. Mer. Tsch.

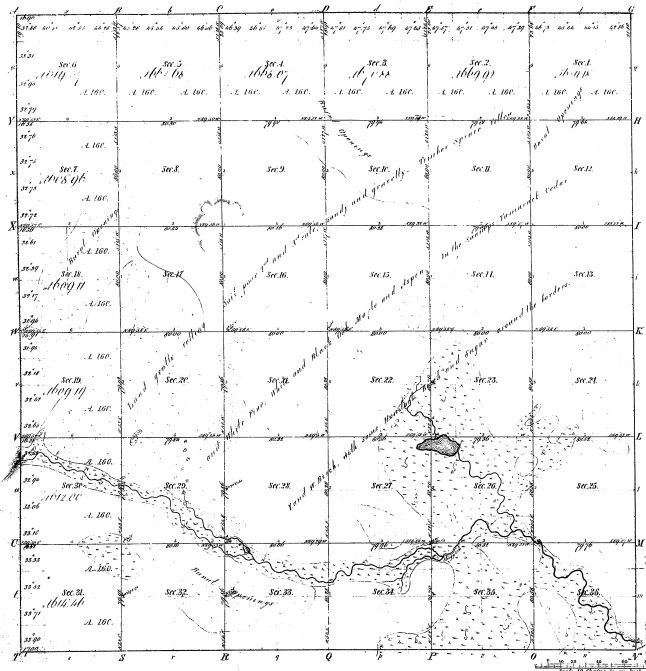

Meanders of

4723

14-23

47
100
1122 1/2
20
72

Total number of Acres 22024.02

Survey designated	By whom surveyed	Date of completion	Amount of Survey	When surveyed	When filed and approved

The above map of Township 1° 25' North of Range 1° 3' West of the Principal Meridian and Longitude is a true and correct copy of the original survey on file in this office, which has been examined and approved.

Surveyor General's Office

Charles D. Kelle
Sur. Genl.

1853