Re Survey

Township No. 26 N. Range No. 1 W. Mer. Mich.

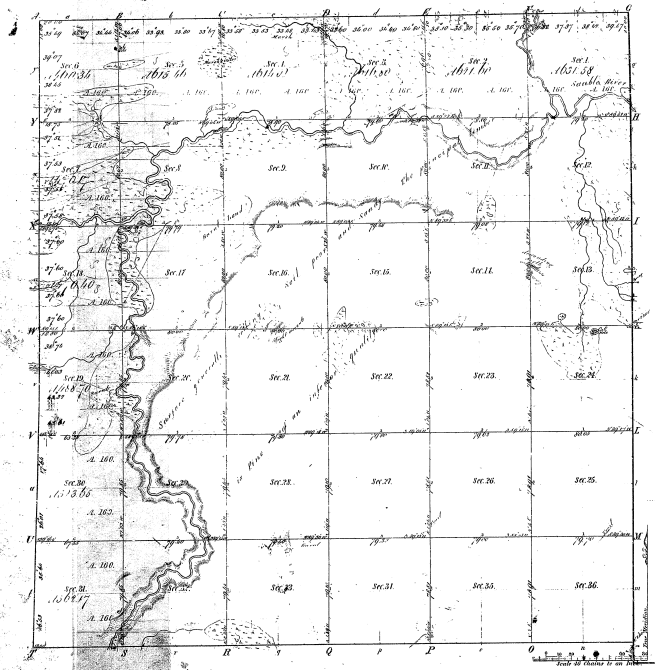

Meanders of

Point	Courses	Dist.	Point	Courses	Dist.	Point	Courses	Dist.

Total number of Acres 22076.80

Surveys Designated	By Whom Surveyed	Date of Contract	Amount of Surveys	When Surveyed	When filed and rec'd in the Surr Gen'l one?
Original	Alex. McDowell	May 19 1839	M. 23	2nd Quar. 1839	
Subdivisions	D. M. Williams	April 18 1862	55. 24. 66	2nd Quar. 1862	

The above Map of Township 26 North of Range No 1 West of the Principal Meridian Michigan is strictly conformable to the field notes of the survey thereof on file in this Office, which have been examined and approved.

Surveyor Generals Office
Detroit Feb 9 1863

Moses Wells
Surv. Gen.

14-20