Resurvey

Township No. 27 N. Range No. 2 W. Mer. Mich.

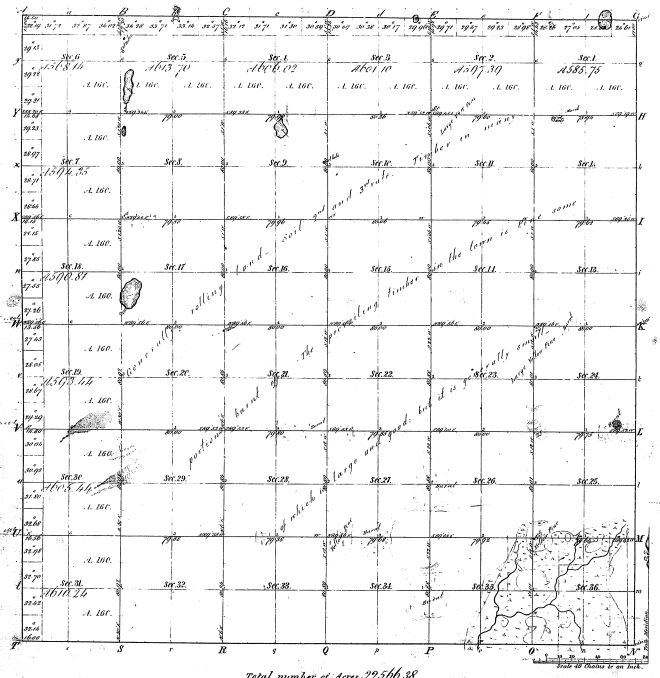

Total number of Acres 23566.38

Surveys Designated	By Whom Surveyed	Date of Contract	Date of Contract	Amount of Surveys	When Surveyed	When 1st or and 2d in the Surr Gen'l was?
Township lines	James H. Wallace	May 18 1830	M. 84	Lin. 82	2nd Quar. 1830	
Subdivisions	D. A. Pollock	June April 13 1842	Sq. 24	Sq. 84	3rd Quarr 1842	

The above Map of Township No 27 North of Range No 2 West of the Principal Meridian Michigan is strictly conformable to the field notes of the survey thereof on file in this Office which have been examined and approved.

Surveyor General's Office,
Detroit Nov. 20 1852

Chas. Metcalfe
Sur. Gen.l

Meanders of

Posts Courses	Posts Courses	Posts Courses

14-14