Re-survey and Retracing

Township. N°2 N. Range. N°2 W. Mer. Mich.

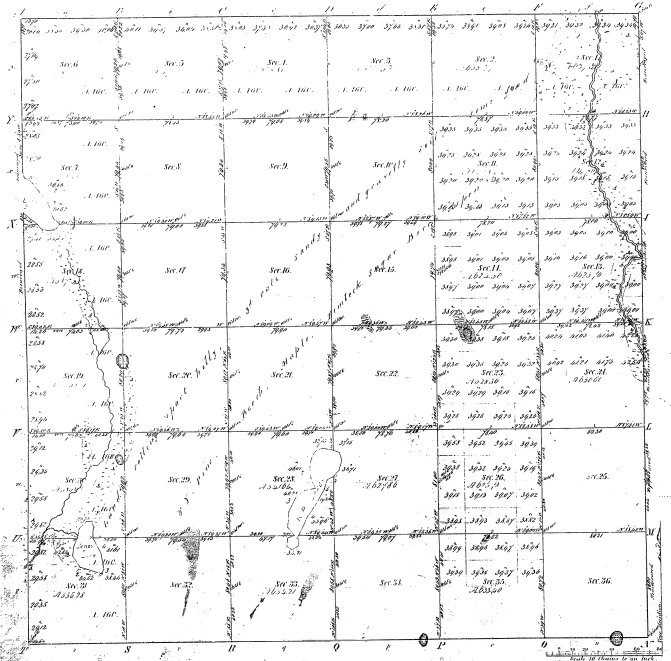

Meander's of Peels Contract 1836 Peels Contract 1836

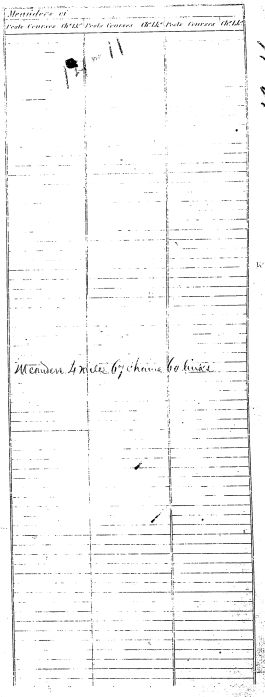

14-11

Total number of Acres 22307.66

Surveys Designated	By Whom Surveyed	Date of Contract	Amount of Surveys	When Surveyed	When 1st and 2d and the Sec. Lines Run out
Township lines & Subdivisions	S. B. Mullett	Sept 11th 1839	1st Qrter 1839		
	Walter Warner	Sept 7th 1840	2d Qrter 1840		
Total surveyed	Walter Warner		3d Qrter 1857		
Total unsurveyed			4. 50. 11		

The above Map of Township 1N 2 North of Range 1W 2 West of the Principal Meridian of Michigan is strictly conformable to the fieldnotes of the survey thereof on file in this Office, which have been examined and approved.

Surveyor General's Office Detroit December 1857

Chief Clerk

Deputy Surveyor