Resurvey

Township No. 28 N. Range No. 4 W. Mer. Mich.

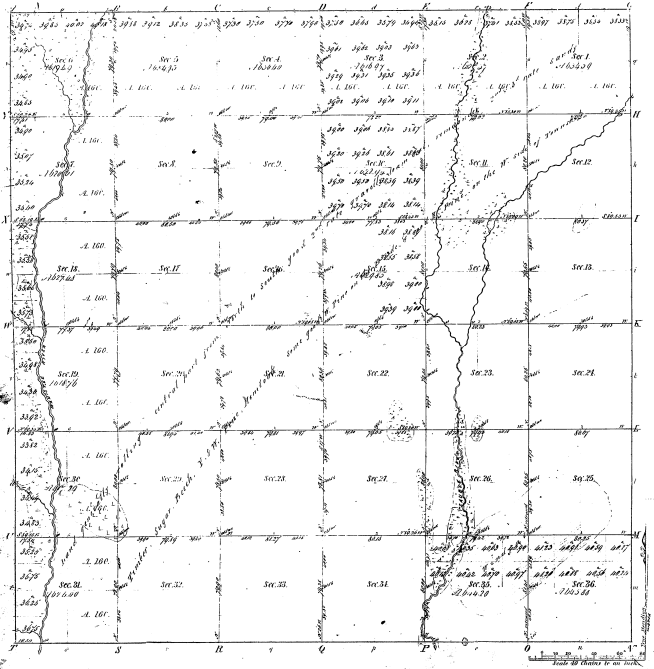

Meanders of					
Poals Courses	Ch.s Lk.s	Poals Courses	Ch.s Lk.s	Poals Courses	Ch.s Lk.s

Note. Lots shaded Yellow sold prior to resurvey.

14-9

Total number of Acres 22,449.93

Surveys Designated	By Whom Surveyed	Date of Contract	Amount of Surveys	When Surveyed	When pd. for and ch.d on the Sur.r Gen.l acc.t
Township Line	James H. Hallett	February 18 1839	M. Ch.s Lk.s 77 - 42	1st Quar. 1839	
Subdivisions	Walter Warner	Sept.r 17th 1838	50. 41. 61.	3d & 4th Quars 1838	

The above Map of Township No. 28 North of Range No. 4 West of the Principal Meridian of Michigan is strictly conformable to the field notes of the survey thereof on file in this Office, which have been examined and approved.

Surveyor Generals Office
St. Paul, October 20th 1857

C. L. Emerson Sur.r Gen.l

16