

48-271

PLAT of GRAVEL ISLAND

IN


LAKE MICHIGAN

in Sec. 12, T. 36 N., R. 20 W., P.M.,

MICHIGAN.

Surveyed by *Walter E. Hoffman*, U.S. Surveyor, Sept. 24, 1912,
under special instructions from the Com'r G.L.O., bearing date June 28, 1912.

Scale: 20 chs. to an inch.

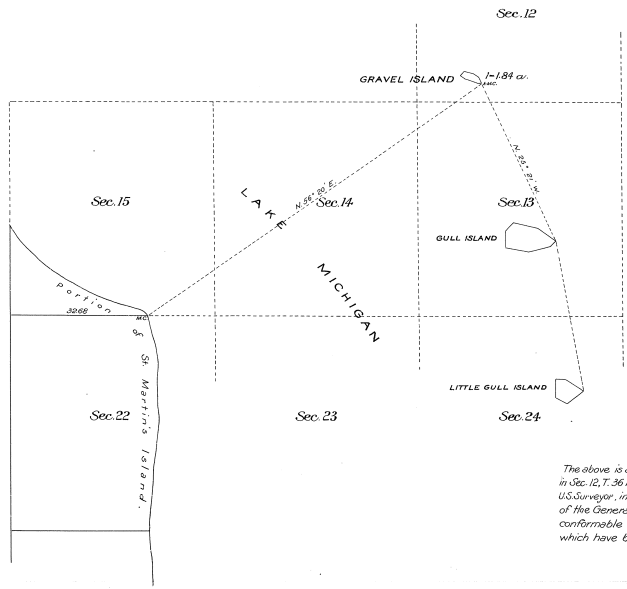

Department of the Interior,
General Land Office
Washington, D.C., June 30, 1913.

The above is a correct plat of survey of Gravel Island in Lake Michigan,
in Sec. 12, T. 36 N., R. 20 W., P.M., Michigan, executed by *Walter E. Hoffman*,
U.S. Surveyor, in pursuance of special instructions from the Commissioner
of the General Land Office, bearing date June 28, 1912, and is strictly
conformable to the field notes of survey thereof on file in this office,
which have been examined and approved.

Walter E. Hoffman
Commissioner in and ex officio
U.S. Surveyor General for Michigan.