46-38

Township No. 38 N. Range No. 19 W. Mer. Mich.

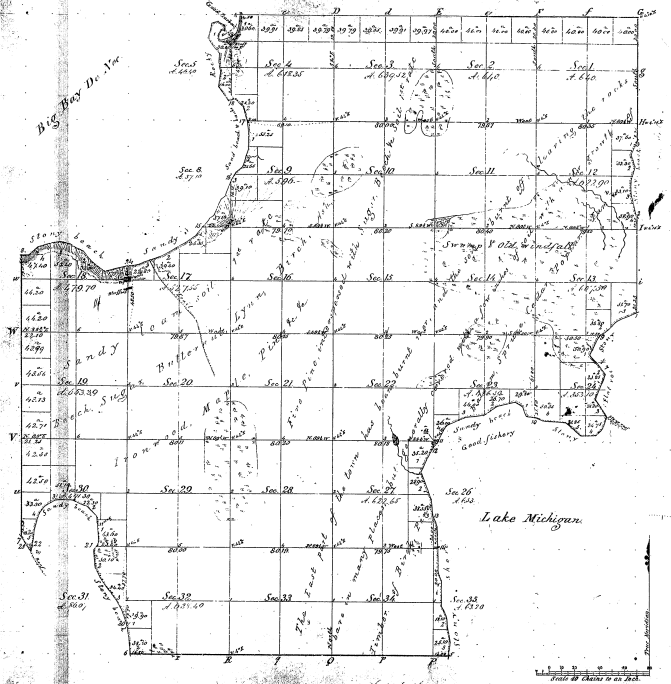

Meanders of								
Parts	Courses	Chs. Lks.	Parts	Courses	Chs. Lks.	Parts	Courses	Chs. Lks.
Total Meanders 13 miles 69 Chains at Lake								

46-38

Total number of Acres 16,536.16

Surveys	Examinations	By Whom Surveyed	Date of Contract	Amount of Surveys M. Chs. Lks.	When Surveyed	When Charged in the Surv. Gen'l acct.
S.R.E.	[illegible]	A. Mesquitas	Feb. 20th 1848	5 08 53	5th 21 1848	
Sub-divisions				14 [illegible] 38		
Meanders				13 [illegible] 21		

The above Map of Township No. 38 North of Range No. 19 West of the Principal Meridian Michigan is a duly conformable to the field notes of the survey thereof on file in this Office, which have been examined and approved.

Surveyor General's Office
Detroit Sept. 2 1848

Lucius Lyon Surv. Genl.