Township No. 38 N. Range No. 20 W. Mer: Mich.

46-37

Meanders of								
Point	Courses	Dist L.P.	Point	Courses	Dist L.P.	Point	Courses	Dist L.P.

46-37

Total Meanders 2 mil. 60 chains 40 links

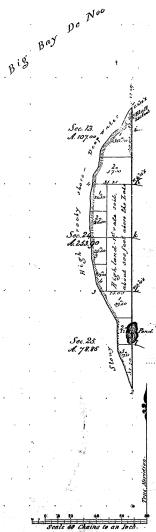

Total number of Acres 430.75

Survey Designated.	By Whom Surveyed.	Date of Contract.	Journal of Surveys M.	CH	Lks	When Surveyed.	When Charged in the Surr Genl's Off.
Township lines.	Thos. R. Ford	Feb. 23 1848	2.	20.	74	3rd Qr. 1848	
Meanders	A. Alvey and others	February 23 1848	2.	60.	40	3rd Qr. 1848	
Subdivisions.				36.	25		

The above Map of Township No. 38 North of Range No. 20 West of the Principal Meridian, Mich. is strictly conformable to the field notes of the survey thereof on file in this Office, which have been examined and approved.

Surveyor General's Office,
Detroit, Sept. 21. 1848.

Lucius Lyons, Surv. Genl.