Township N.º 38 N. Range N.º 23 W. Mer. Mich.

46-34

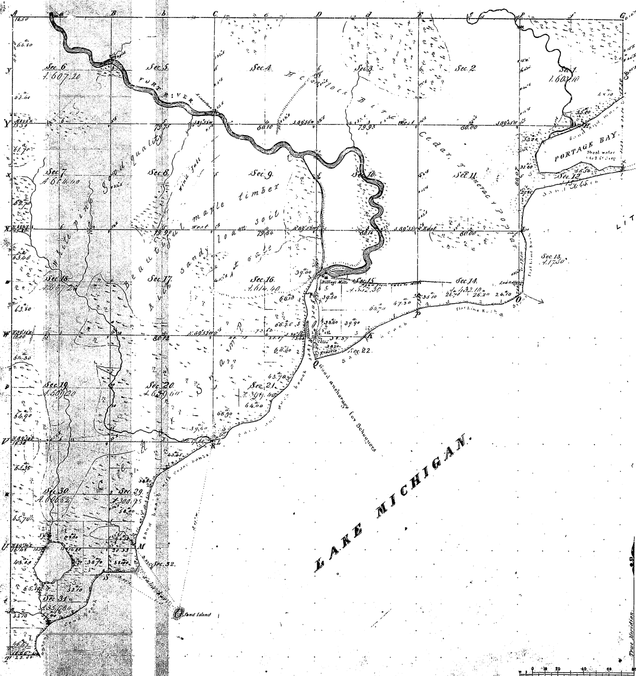

Meanders of								
Posts	Courses	Chs. Lks.	Posts	Courses	Chs. Lks.	Posts	Courses	Chs. Lks.

Total number of Acres 12.947.69

Surveys Designated	By Whom Surveyed.	Date of Contract.	Amount of Surveys. M. Chs. Lks.	When Surveyed.	When Charged in the Surr. Genl's acct.
Township [illegible]	[illegible]	[illegible] 1845	[illegible]	2nd qr. 1845	
Subdivisions	A. Burgwarther	July 10. 1846	47 15 09	2nd qr. 1847	

The above Map of Township No. 38 North of Range No. 23 West of the Principal Meridian Michigan is strictly conformable to the field notes of the survey thereof on file in this Office, which have been examined and approved.

Surveyor Generals Office,
Detroit June 24 1847

Lucius Lyon, Surr. Genl.