Township N° 41 N. Range N° 22 W Mer. Mich

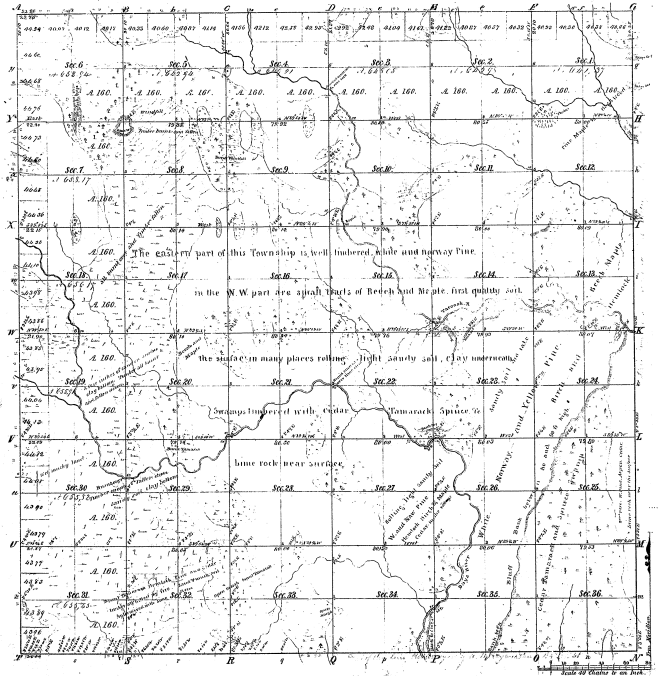

Meanders of					
Poste	Courses	Dist's	Poste	Courses	Dist's	Poste	Courses	Dist's

38-35-1

38-35

Total number of Acres 23,165.01

Surveys Designated	By Whom Surveyed	Date of Contract	Amount of Surveys	When Surveyed	When & for and dist. on the Surv. Gen.l maps
Township lines	John Brown	July 26 1824	M 85 46	2nd qr 1825	
Subdivisions	A. Meyers & others	July 26 1824	84 11 11	2nd qr 1827	

The above Map of Township N° 41 North of Range N° 22 West of the Principal Meridian Michigan, is strictly conformable to the field-notes of the survey thereof on file in this Office, which have been examined and approved.

Surveyor Generals Office
Detroit, December 30 1837

Lucius Lyon, Surv. Gen.l